

Addendum 01

To: Bidding Documents
Plan-Holders of Record
Project File

Date: April 21, 2025
Addendum Number: One
Architect's Project #: 20210121.56
Project Name: Stilwell Cultural Center

From: **BLUE RIVER ARCHITECTS, LLC**
320 South Boston, Suite 103
Tulsa, Oklahoma 74103
Tel 918.877.9036

Professional Seal:



NOTICE.....

This Addendum supplements and amends the original Bidding Documents, shall be taken into account in preparing proposals, and shall become a part of the Construction Documents. The bidder shall indicate receipt of this addendum and all previously issued addenda on the Bid/Proposal Form.

PRIOR ADDENDA

NONE

Bidder Questions

1. Question: Is there a hardware schedule for this project? Or are we just to assume that each door requires a cylindrical lockset, threshold, and hinges?
 - a. Response: Please refer to Sheet CS – Division 8 – Hardware for CN core standard. All new doors to receive hinge, closer, and stop accessories to match existing conditions.
2. Question: Sheet ID101 does not have room 111 in the finish schedule but it appears that it will receive LVT-1, can you confirm this?
 - a. Response: Room 111 has been added to the finish schedule. LVT-1 and RB-1 to be installed. Walls and ceiling to remain.
3. Question: Sheet A101 says that room 112 is in our scope, sheet ID101 says room 112 is NOT in our scope, but the finish schedule on ID101 calls for room 112 to receive sealed concrete. Can you clarify?
 - a. Response: Finish plan has been revised on ID101. Finish legend revised to include note for scope of C-1.
4. Question: Assuming room 112 will receive sealed concrete and new rubber base, should the adjoining electrical room receive new sealed concrete and rubber base as well?
 - a. Response: No, electrical room is out of scope.

5. Question: When this bid last year our request to use Moisture Resistant Particle Board on sub tops was approved. Will that approval carry over to this bid?
a. Response: Yes, still approved.
6. Question: Regarding the wall types on Sheet A101, the east wall of the gallery, room 116, is calling for a wall type of "Bg 0". However, there is no sub type 'g' in the partition schedule. Please clarify.
a. Response: "Bg0" has been removed from the project and replaced with "Cf0" – a 2-1/2" metal framed wall with 5/8" gypsum board.
7. Question: In Kiln Room 113, alternate #3, it shows what looks to be a CMU to be built to form the room, however there is no call out for wall type in the prints. Please clarify.
a. Response: Wall tags added to 8" CMU walls.
8. Question: In rooms 105 and 106, the finish legend on ID101 calls for the west walls to receive a paint finish, but in elevation A & B on A701 calls for them to receive 'WT-1'. 'WT-1' is not in the finish legend on sheet ID101. Please advise of the wall finish required.
a. Response: WT-1 added to finish legend.
9. Question: On sheet A101, in community room 106, please advise of the structural attachment at the roof deck line for hanging the operable wall panel in alternate #2. The door company will provide structural required at the door header but not structural design at the roof deck attachment.
a. Response: Operable wall to mount to delegated design steel portal frame. No connections to roof deck necessary. Delegated design to include steel column footings.

Changes / Clarifications To Specifications:

NONE

Changes / Clarifications To Drawings

1. Sheet CS – Cover Sheet
 - 1.1 Removed Civil related specifications from specifications list
2. Sheet AD101 – Demolition Plans
 - 2.1 Demolition Keynotes – revised keynote #4
 - 2.2 Demolition Keynotes – revised keynote #5
 - 2.3 Demolition Keynotes – added keynote #13
 - 2.4 Located / noted extent of pallet curb demolition
 - 2.5 Added note to salvage all existing compressor equipment for Owner use
 - 2.6 Added note to patch exterior wall openings where ductwork is to be removed
3. Sheet A101 – Floor Plans and Schedules
 - 3.1 Added notes to paint existing exterior double doors at main entrance
 - 3.2 Added 2-1/2" furr out walls along plan east and west walls of Gallery 116
 - 3.3 Added note at Work Area 114B that all equipment is Owner provided
 - 3.4 Added note to patch exterior wall openings where ductwork is to be removed
 - 3.5 Added wall tags at Kiln Room 113 walls

4. Sheet A121 – Ceiling Plans and Details
 - 4.1 Sheet details have been reorganized
 - 4.2 Detail B/A121 added to project
5. Sheet A201.A – Exterior Elevations and Details – Alternate #1
 - 5.1 Drawing D/A201.A – revised canopy soffit note
6. Sheet ID101 – Interior Finish Plan
 - 6.1 Finish Legend – added WT-1 product information
 - 6.2 Finish Schedule – noted for new paint at Women's Restroom 117 and Men's Restroom 119
 - 6.3 Added note for moisture control membrane at all LVT-1 locations

End of Summary**LIST OF ATTACHMENTS**

Sheet CS – COVER SHEET
Sheet AD101 – DEMOLITION PLANS
Sheet A101 – FLOOR PLANS AND SCHEDULES
Sheet A121 – CEILING PLANS AND DETAILS
Sheet A201.A – EXTERIOR ELEVATIONS AND DETAILS – ALTERNATE #1
Sheet ID101 – INTERIOR FINISH PLAN

END OF ADDENDUM

CHEROKEE NATION BUSINESSES STILWELL CULTURAL CENTER

SPECIFICATIONS

SPECIFICATION INDEX

Division 0	General Conditions	Division 6	Wood and Plastics	Division 12	Furnishings
Division 1	General Requirements	Division 7	Thermal and Moisture Protection	Division 13	Special Construction
Division 2	Site Work	Division 8	Doors and Windows	Division 14	Conveying Systems
Division 3	Concrete	Division 9	Finishes	Division 21	Fire Suppression
Division 4	Masonry	Division 10	Specialties	Division 22	Plumbing
Division 5	Metals	Division 11	Equipment	Division 23	Mechanical
Division 24	Electrical	Division 25	Fire Detection and Alarm		

DIVISION 0: GENERAL CONDITIONS
OWNER: Cherokee Nation
P.O. BOX 348
TAHLEQUAH, OK 74465
P(918) 453-5000
ARCHITECT: Blue River Architects, LLC
320 S BOSTON AVE, SUITE 103
TULSA, OK 74103

SITE EXAMINATION: The Contractor shall visit the project site and examine all existing conditions affecting the work.
PROTECTION: The Contractor shall take all responsible precautions to protect from damage, injury or loss of all the Work and all the materials and equipment incorporated herein. The Contractor shall promptly remedy at his own expense and to the Owner's satisfaction, all damage or loss to the Work and all material and equipment incorporated therein.
MANUFACTURER'S DIRECTIONS: All manufactured articles, materials and equipment shall be applied, installed connected, erected, used, cleaned and conditioned as directed by the manufacturer.
WORKMANSHIP: Compliance with the Drawings and Specifications with regards to materials and methods will, not in itself, assure acceptance of the construction. Of equal importance is good workmanship, the lack of which will be sufficient cause to refuse acceptance of the Work. Any discrepancies concerning quality of workmanship are to be remedied to the satisfaction of the Owner in accordance with quality construction practices.
WORK AND MATERIALS NOT COVERED IN SPECIFICATIONS: Any item not specifically covered by the Drawings and / or Specifications, but which can be assumed as necessary for proper completion of the Work shall be considered as part of the Contract and shall be performed in a good workmanlike manner. All items specified are to have final approval of the Owner. Any item specified as "By Owner" is to be selected and / or purchased by the Owner. Coordinate all items provided by the Owner, which is to be incorporated into the Work.

SUBCONTRACTOR APPROVAL: The Owner shall have the right to approve all subcontractors prior to the signing of the Contract. The Contractor shall use only Owner approved subcontractors during the course of the Work.

DIVISION 1: GENERAL REQUIREMENTS
MANUFACTURER'S RECOMMENDATIONS/WARRANTY: Install all components per manufacturer's recommendations to achieve manufacturer's warranty.
PERMITS, FEES AND NOTICES: The Contractor shall be responsible for all permits, fees, and notices.
CODE COMPLIANCE: The Contractor shall be responsible for compliance with all applicable governing local, state, and national laws, ordinances, rules, regulations, and codes.

SCOPE OF WORK: The Contractor shall furnish and install all materials and equipment as shown on the Drawings and / or described in these Specifications, and other items selected and / or provided by the Owner. The Contractor shall furnish all labor, tools, equipment, and transportation necessary to complete the Work.
MEASUREMENT AND DIMENSIONS: Before ordering materials or commencing with work which is dependent upon proper sizing of, or installation in existing previous conditions, the Contractor shall verify all existing dimensions and shall be responsible for their correctness.
LAYOUT OF WORK: The Contractor shall be responsible for the layout of the work on the premises or elsewhere by the Contractor who will be held responsible for its correctness.

SPECIFICATIONS DIVISIONS: The organization of these Specifications into division is for the purpose of uniform coordination of the Work. It shall be the Contractors responsibility for proper coordination and completion of the Work.
SITE UTILITIES: Verify location of all site utilities before commencing work.
TRENCHING: Clean bottom and firm sides for concrete pour.
CLEANUP: Contractor shall maintain site in a neat and orderly condition on a daily basis.
TOPSOIL: Stockpile for replacement during final grading.


SOIL TREATMENT CONTROL: Dursban TC by Dow Chemical. Termite treat under all slabs, around both sides of foundation.
DIVISION 4: MASONRY
Reference drawings for masonry veneer information.
DIVISION 5: METAL
STEEL: ASTM A36.
FRAMING: ASTM C195, studs formed to Channel, "C", or Sigma shape with punched web; U-shaped track in matchin nominal width and compatible height.
FRAMING CONNECTIONS:
Gage: As required to meet L240 span rating
Depth: As indicated on the Drawings.
Galvanized in accordance with ASTM A653/A653M G90/Z275 coating.

DIVISION 6: WOOD AND PLASTICS
CABINETS: Custom wood cabinets, AWW premium grade; Design and style as indicated on the Drawings.
CABINETS WITH PLASTIC LAMINATE FINISH: Custom AWW premium grade; Underlayment APA rated Marine grade plywood suitable for wet locations, 3/4" thickness. Adhesive to be solvent release type for wet areas.
ROUGH CARPENTRY: Provide fire retardant treated wood.
Miscellaneous Framing, Blocking, Nasters, Grounds, and Furring.
1. Lumber: S4S, No. 2 or Standard Grade.
2. Boards: standard or No. 3.
Miscellaneous Blocking, Furring, and Nailers
1. Lumber: S4S, No. 2 or Standard Grade.
2. Boards: Standard or No. 3.
Exterior Wall Sheathing
1. Span Rating: 24/0.
2. 7/16" inch, nominal.
DIVISION 7: THERMAL & MOISTURE PROTECTION
THERMAL INSULATION:
CEILING: Fiberglass batt insulation R-30 min.
EXTERIOR WALL SHEATHING:
Basis of Design: USG Securock Glass-Mat Sheathing
AIR BARRIERS:
Basis of Design: Dyrwit Backstop NT
20 mil thickness minimum
Air permeance: 0.004 cmh/sq, maximum when tested in accordance with ASTM E2178
SEALANTS:
One component polyurethane by Vulkem
DIVISION 8: DOORS, WINDOWS, & GLASS
EXTERIOR DOORS: Hollow metal doors, design and grade selected by Owner.
INTERIOR DOORS: Hollow metal doors, design and grade selected by Owner, refer to Finish Schedule for Materials.
THRESHOLD: Finish to match door hardware.
HARDWARE: Schlage Everest 20 cylindrical core.
INTERIOR NON RATED WINDOWS:
Product: Hollow metal frames, 1/4" tempered glazing
DOOR FRAMES: ANSI Z90.8, for level 1-16 gage, factory primed for field finishing, face welded seamless with filled joints.

DIVISION 9: FINISHES
GYPSUM BOARD: Modular resistant gypsum board in all wet areas.
5/8" type "X" gypsum board.
Joint Tape: USG perfa-tape
FLOORS: Refer to Room Finish Schedule.
BASE: Refer to Room Finish Schedule.
ACOUSTIC LAY-IN CEILING: Refer to Room Finish Schedule for type. Heavy-duty in accordance with ASTM C635/C635M. Provide closed-cell foam gaskets and hold down clips.
PLASTIC LAMINATE: Cabinets with plastic laminate finish. Refer to Room Finish Schedule.
EXTERIOR PAINTING AND COATINGS: Refer to Room Finish Schedule.
Exterior Masonry Brick Paint (EPT-2) Basis of Design:
Primer: Sherwin Williams LUXON Concrete & Masonry Primer / Sealer
Topcoat: Sherwin Williams LUXON Masonry Topcoat
INTERIOR PAINTING: Refer to Room Finish Schedule.

FIRE EXTINGUISHERS, CABINETS AND ACCESSORIES: Semi recessed cabinet, Surface mounted when located on cmu 10lb extinguishers.
DIVISION 10: SPECIALTIES
Not Used
DIVISION 11: EQUIPMENT
Not Used
DIVISION 12: FURNISHINGS
Not Used
DIVISION 13: SPECIAL CONSTRUCTION
STRUCTURAL STEEL: Shall conform to ASTM A529, ASTM A572, ASTM A992 and/or ASTM A36.
DIVISION 14: CONVEYING SYSTEMS
Not Used
DIVISION 15: MECHANICAL
Refer to Mechanical
DIVISION 16: ELECTRICAL
Refer to Electrical
DIVISION 31: EARTHWORK
Refer to Architectural Sheets

END OF SPECIFICATIONS

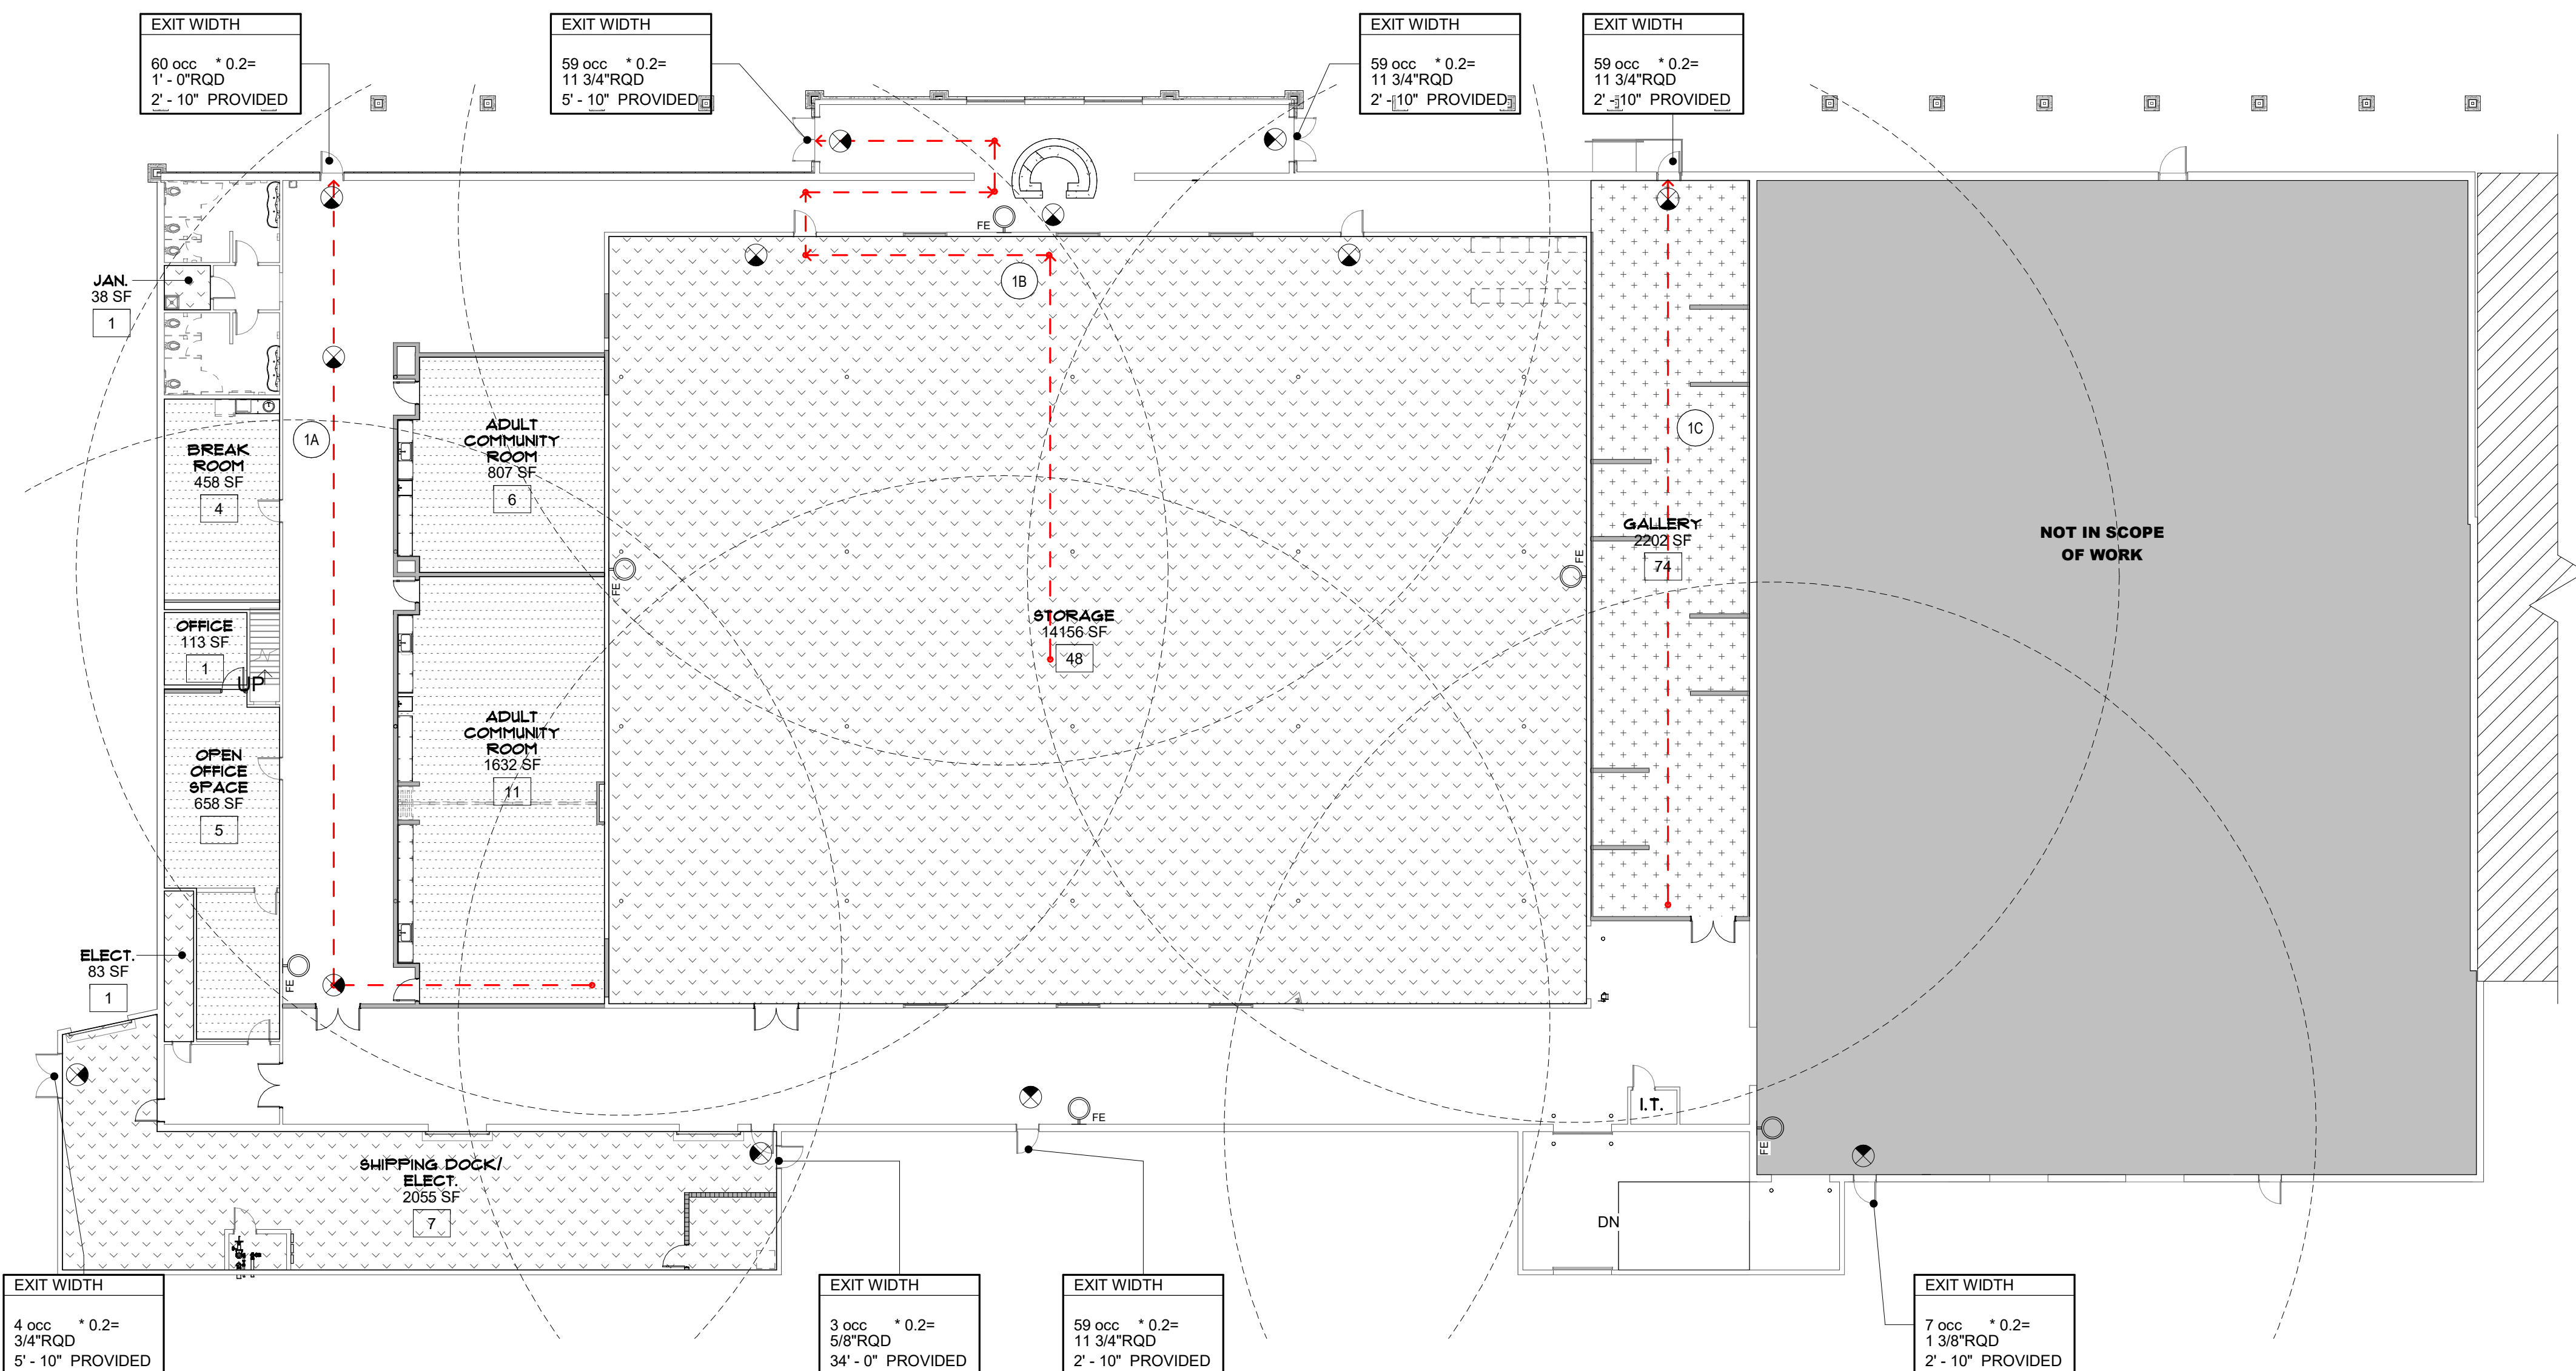

A FIRST FLOOR - CODE PLAN

1/16" = 1'-0"

DETAILED CODE INFORMATION

SUMMARY
THE BUILDING DEPICTED IN THESE CONSTRUCTION DOCUMENTS IS A FORMER MANUFACTURING FACILITY CONVERTED INTO AN ARTS STORAGE FACILITY, GALLERY SPACE, AND BUSINESS AREAS.

APPLICABLE CODES
2018 INTERNATIONAL EXISTING BUILDING CODE (IEBC)
2018 INTERNATIONAL BUILDING CODE (IBC)
2018 INTERNATIONAL PLUMBING CODE (IPC)
2020 NATIONAL ELECTRIC CODE (NEC)
2018 INTERNATIONAL FIRE CODE (IFC)
2018 INTERNATIONAL MECHANICAL CODE (IMC)
2010 ADA ACCESSORY GUIDELINES FOR BUILDINGS AND FACILITIES (ADA)
2009 AMERICAN NATIONAL STANDARDS A117.1

USE OR OCCUPANCY

304 GROUP S-1

GENERAL BUILDING HEIGHTS AND AREAS
NON-SEPARATED USE GROUPS: S-1, TYPE VB NON-COMBUSTIBLE SPRINKLERED:
TABLE 504.3 ALLOWABLE BUILDING HEIGHT 60 FEET
TABLE 504.4 ALLOWABLE NUMBER OF STORIES 2 STORIES
TABLE 506.2 ALLOWABLE BUILDING AREA 30,000 SF

TABLE 507.2.1 PUBLIC WAYS IN WIDTH OF 60 FEET IN WIDTH REQUIRED SHALL BE PERMITTED TO BE REDUCED TO NOT LESS THAN 40 FEET IN WIDTH PROVIDED:
1. THE REDUCED WIDTH SHALL NOT BE ALLOWED MORE THAN 75 PERCENT OF PERIMETER
2. THE EXTERIOR WALL FACING THE REDUCED WIDTH SHALL HAVE A FIRE RESISTANCE RATING OF NOT LESS THAN 3 HOURS
3. OPENINGS IN EXTERIOR WALL FACING REDUCED WIDTH SHALL HAVE OPENING PROTECTIVES WITH A FIRE RATING OF NOT LESS THAN 3 HOURS

TABLE 507.5 THE AREA OF A GROUP B, F, M OR S BUILDING NO MORE THAN TWO STORES ABOVE GRADE PLANE SHALL NOT BE LIMITED WHERE THE BUILDING IS EQUIPPED WITH AN AUTOMATIC SPRINKLER SYSTEM IN ACCORDANCE WITH SECTION 903.1.1 AND IS SURROUNDED AND ADJOINED BY PUBLIC WAYS OR YARDS NOT LESS THAN 60 FEET IN WIDTH

TABLE 508.2.1 AREA LIMITATIONS:
AGGREGATE ACCESSORY OCCUPANCIES SHALL NOT OCCUPY MORE THAN 10 PERCENT OF THE BUILDING AREA OF THE STORY IN WHICH THEY ARE LOCATED AND SHALL NOT EXCEED THE TABULAR VALUES IN TABLE 503, WITHOUT AREA INCREASES IN ACCORDANCE WITH SECTION 506 FOR SUCH ACCESSORY OCCUPANCIES.

TABLE 508.4 REQUIRED SEPARATION OF OCCUPANCIES
S-1 AND B: NONE

TYPE OF CONSTRUCTION

TABLE 602.3 TYPE VB SPRINKLERED

TABLE 601	STRUCTURAL ELEMENT	FIRE RESISTANCE RATING
	STRUCTURAL FRAME	0
	BEARING WALLS	0
	EXTERIOR	0
	INTERIOR	0
	NON-BEARING WALLS	0
	EXTERIOR	0
	INTERIOR	0
	FLOOR CONSTRUCTION	0
	ROOF CONSTRUCTION	0

TABLE 602 FIRE-RESISTANCE RATING REQUIRED FOR EXTERIOR WALLS BASED ON FIRE SEPARATION DISTANCE:
GROUP S-1

	X < 5	2 HOUR
	5 < X < 10	1 HOUR
	10 < X < 30	0 HOUR
	X > 30	0 HOUR

PROJECT CONTACTS

OWNER:

CHEROKEE NATION
P.O. BOX 348
TAHLEQUAH, OK 74465
P(918) 453-5000


ARCHITECT:

BLUE RIVER ARCHITECTS, LLC
1300 E 6TH ST
TULSA, OK 74103
P(918) 587-6158

MEP:

CROWMELL ARCHITECTS ENGINEERS
1300 E 6TH ST
LITTLE ROCK, AR 72202
P(501) 372-2900

LOCATION MAP

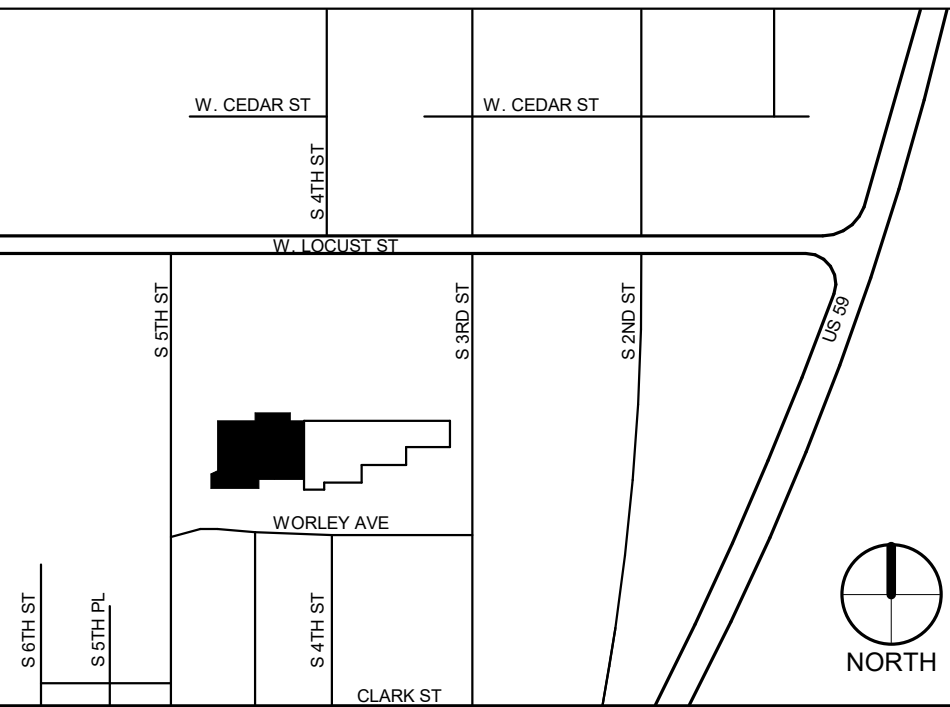

SHEET INDEX

GENERAL	MECHANICAL
C3 COVER SHEET	M-001 MECHANICAL LEGEND, SYMBOLS, AND SPECIFICATIONS
A1-01 DECONSTRUCTION PLANS	M-002 MECHANICAL SPECIFICATIONS
A1-01 FLOOR PLANS AND SCHEDULES	M-003 FIRST FLOOR MECHANICAL DEPO PLAN
A2-01 CEILING PLANS AND DETAILS	M-004 FIRST FLOOR MECHANICAL PLAN
A2-01 EXTERIOR ELEVATIONS AND DETAILS	M-005 ROOF MECHANICAL PLAN
A2-01 A BASE BID	M-006 MECHANICAL DETAILS
A2-01 B EXTERIOR ELEVATIONS AND DETAILS	M-007 MECHANICAL SCHEDULES
A2-01 C EXTERIOR ELEVATIONS AND DETAILS	M-008 MECHANICAL SCHEDULES
A2-01 D EXTERIOR ELEVATIONS AND DETAILS	M-009 MECHANICAL SCHEDULES
A2-01 E EXTERIOR ELEVATIONS AND DETAILS	M-010 MECHANICAL SCHEDULES
A2-01 F EXTERIOR ELEVATIONS AND DETAILS	M-011 MECHANICAL SCHEDULES
A2-01 G EXTERIOR ELEVATIONS AND DETAILS	M-012 MECHANICAL SCHEDULES
A2-01 H EXTERIOR ELEVATIONS AND DETAILS	M-013 MECHANICAL SCHEDULES
A2-01 I EXTERIOR ELEVATIONS AND DETAILS	M-014 MECHANICAL SCHEDULES
A2-01 J EXTERIOR ELEVATIONS AND DETAILS	M-015 MECHANICAL SCHEDULES
A2-01 K EXTERIOR ELEVATIONS AND DETAILS	M-016 MECHANICAL SCHEDULES
A2-01 L EXTERIOR ELEVATIONS AND DETAILS	M-017 MECHANICAL SCHEDULES
A2-01 M EXTERIOR ELEVATIONS AND DETAILS	M-018 MECHANICAL SCHEDULES
A2-01 N EXTERIOR ELEVATIONS AND DETAILS	M-019 MECHANICAL SCHEDULES
A2-01 O EXTERIOR ELEVATIONS AND DETAILS	M-020 MECHANICAL SCHEDULES
A2-01 P EXTERIOR ELEVATIONS AND DETAILS	M-021 MECHANICAL SCHEDULES
A2-01 Q EXTERIOR ELEVATIONS AND DETAILS	M-022 MECHANICAL SCHEDULES

CHEROKEE NATION BUSINESSES - CULTURAL CENTER

314 W. LOCUST ST., STILWELL, OK, 74960

COVER SHEET



320 South Boston Avenue, Suite 103
Tulsa, Oklahoma 74103
918.408.6686
blueriverarchitects.com

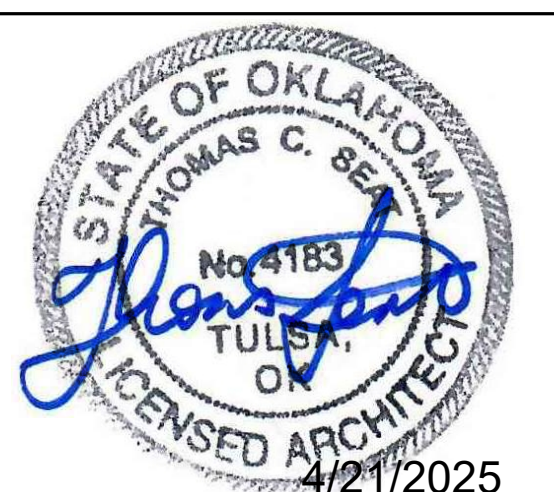

ARCHITECT: Thomas Seat
LICENSE # 4183

PROJECT #: 20200132

ISSUE DATES:

CONSTRUCTION DOCUMENTS

No. Description Date

2 ADDENDUM #01 04/21/2025

SHEET NUMBER:

CS

© 2025 COPYRIGHT BLUE RIVER ARCHITECTS, LLC

ISSUE DATES:		
CONSTRUCTION DOCUMENTS		
No.	Description	Date
2	ADDENDUM #01	04/21/2025

DEMOLITION LEGEND


- EXISTING PARTITIONS, WIDTH OF PARTITION VARIES
- REMOVE EXISTING CONCRETE SLAB
- ITEM TO BE DEMOLISHED
- DEMOLITION KEYNOTE

DEMOLITION KEYNOTES

- REMOVE PORTION OF PARTITION TO RECEIVE NEW DOOR. PREPARE SURROUNDING EXISTING FINISHES FOR DOOR FRAME.
- REMOVE EXISTING CEILING, LIGHTING, HVAC COMPONENTS, ELECTRICAL, SECURITY, AND CABLE SYSTEM.
- REMOVE EXISTING FLOORING SYSTEM. PREPARE SUBSTRATE TO RECEIVE NEW SELF-LEVELING COMPOUND AND NEW FLOORING SYSTEM. CONCRETE PATCH REPAIR MAY BE REQUIRED FOR EXCESSIVE DAMAGE.
- REMOVE EXISTING PARTITION TO RECEIVE NEW WALLBASE. REMOVE EXISTING WALLBASE TO RECEIVE NEW WALLBASE.
- REMOVE EXISTING PARTITION TO DECK. CAREFULLY REMOVE ANY DOOR, WINDOW, OR PARTITION. PATCH AND REPAIR FLOORING TO MATCH EXISTING CONDITIONS.
- REMOVE EXISTING DOOR AND/OR WINDOW, FRAME, AND HARDWARE. INFILL OPENING TO MATCH ADJACENT PARTITION. PAINT TO MATCH.
- REMOVE PLUMBING FIXTURE. PREPARE FOR NEW FIXTURE SYSTEM.
- REMOVE EXISTING MILLWORK AND FURNITURE SYSTEM.
- FIELD VERIFY EXTENT OF CEILING DEMOLITION. COORDINATE WITH MECHANICAL.
- REMOVE AND SALVAGE EXISTING FABRIC COILING DOOR FOR OWNER STORAGE.
- REMOVE AND SALVAGE EXISTING TOILET PARTITIONS, REINSTALL AFTER NEW FLOORING INSTALLATION.
- REMOVE PORTION OF EXISTING SLAB. PREPARE TRENCH FOR NEW PLUMBING LINES. COORDINATE WITH PLUMBING DOCUMENTS.
- REMOVE PALLET CURBS IN THEIR ENTIRETY. PATCH AND REPAIR FLOORING TO RECEIVE NEW FINISH.

DEMOLITION GENERAL NOTES

- CONTRACTOR TO COORDINATE ALL DEMOLITION WORK WITH NEW CONSTRUCTION AND RENOVATION PRIOR TO START.
- ALL ITEMS SHOWN ON DEMOLITION PLANS WITH DASHED LINEWORK ARE TO BE REMOVED. SEE ADDITIONAL NOTES ON FLOOR PLAN.
- CONTRACTOR IS RESPONSIBLE FOR VERIFYING QUANTITY OF MATERIALS REQUIRED FOR DEMOLITION AND NEW CONSTRUCTION.
- CONTRACTOR TO DISPOSE OF ALL ITEMS IN A LEGAL MANNER.
- CARE SHALL BE TAKEN TO LOCATE AND PROTECT ANY STRUCTURAL COMPONENTS THAT ARE WITHIN WALLS, CEILINGS OR FLOORS UNLESS SPECIFICALLY IDENTIFIED TO BE REMOVED.
- REMOVE EXISTING INTERIOR PARTITIONS AS INDICATED ON PLAN TO ACCOMMODATE NEW CONSTRUCTION. COORDINATE WITH MECHANICAL AND ELECTRICAL DRAWINGS FOR REUSED OR RELOCATED DEVICES OR FIXTURES. CONTRACTOR SHALL CONFIRM IF A WALL IS OR IS NOT LOAD BEARING PRIOR TO REMOVING ANY PORTION. IF A WALL IS FOUND TO BE LOAD BEARING, AND IS NOT ADDRESSED IN THE DRAWINGS, THE CONTRACTOR SHALL CONTACT THE ARCHITECTS FOR DIRECTIONS TO RETAIN STRUCTURAL INTEGRITY OF THE SUPPORTED STRUCTURE.
- PATCH AND REPAIR EXISTING SUBSTRATES THAT ARE TO REMAIN AS REQUIRED TO PREPARE THEM FOR NEW WORK AND FINISHES AS DEFINED ELSEWHERE IN THE DOCUMENTS.
- DUST WALLS SHALL BE INSTALLED AS NEEDED TO ISOLATE DEMOLITION AREA FROM OCCUPIED AREA. COORDINATE WITH OWNER. MAINTAIN FIRE EXITS AT ALL TIMES.
- FIRE EXTINGUISHERS IN THE AREA OF WORK SHALL REMAIN. CONTACT ARCHITECT FOR REVISED LOCATION WHERE EXISTING FIRE EXTINGUISHERS AND/OR FIRE EXTINGUISHER CABINETS ARE LOCATED ON WALLS TO BE REMOVED.
- REMOVED EXISTING LIGHT FIXTURES AND CEILINGS IN THEIR ENTIRETY. UNLESS NOTED OTHERWISE, DE-ENERGIZE CIRCUITS UNTIL READY FOR NEW LIGHTING. COORDINATE WITH ELECTRICAL PLANS TO DETERMINE IF CIRCUITS WILL BE REUSED, RELOCATED, OR ABANDONED. REMOVE CONDUCTORS AND CONDUIT BACK TO SOURCE FOR CIRCUITS THAT WILL BE ABANDONED.
- REMOVE ELECTRICAL CONDUCTORS BACK TO THE SOURCE. EMPTY CONDUIT WITHIN WALLS AND ABOVE CEILINGS THAT ARE NOT OTHERWISE MODIFIED. IF CIRCUITS ARE TO BE RELOCATED OR REINSTALLED IN NEW WORK, DE-ENERGIZE CIRCUITS UNTIL RELOCATED. REMOVE CONDUCTORS AND CONDUIT BACK TO SOURCE FOR CIRCUITS THAT WILL BE ABANDONED.
- REMOVE ALL ABANDONED AND NON-OPERATIONAL CABLING ABOVE CEILINGS IN AREA OF WORK. TAKE CARE TO NOT CUT EXISTING DATA OR FIBER THAT IS TO REMAIN FOR THE FUNCTIONING IT ROOM/SERVER.
- REFER TO MECHANICAL, ELECTRICAL, AND PLUMBING DEMOLITION DRAWINGS FOR ADDITIONAL INFORMATION.
- REMOVE OUTLETS, SWITCHES, AND WIRING IN PARTITIONS IDENTIFIED TO BE REMOVED. WIRING TO BE REMOVED BACK TO CLOSEST WALL TO REMAIN AND TERMINATED IN NEW JUNCTION BOX PROVIDED BY CONTRACTOR.
- REMOVE AND DISPOSE OF EXISTING PARTITIONS SHOWN DASHED. REMOVE PARTITIONS TO STRUCTURE ABOVE. UNLESS NOTED OTHERWISE, PATCH AND REPAIR FLOOR SLAB AS REQUIRED TO MAKE READY FOR NEW CONSTRUCTION. IF REMAINING WALL IS COMPROMISED, NOTIFY ARCHITECT IMMEDIATELY.
- CAREFULLY REMOVE ITEMS IDENTIFIED AS SALVAGE OR SCHEDULED FOR RE-USE. STORE IN PROTECTED AREA UNTIL REINSTALLATION IS ACHIEVED. REPAIR DAMAGE CAUSED BY CARELESS REMOVAL OR IMPROPER STORAGE, OR REPLACE SUCH ITEMS TO OWNER'S SATISFACTION.
- REMOVE AND DISPOSE OF EXISTING FLOORING IN AREAS SHOWN TO BE REPLACED. REMOVE TO SUBSTRATE, LEAVING SURFACE READY FOR INSTALLATION OF NEW FINISH AS SCHEDULED. PATCH HOLES AND IMPERFECTIONS IN SUBSTRATE AS REQUIRED.
- CONTACT ARCHITECT BEFORE REMOVING OR DEMOLISHING ANY EXISTING CONSTRUCTION OR ITEMS NOT SHOWN TO BE REMOVED.
- CAREFULLY REMOVE FIXTURES, RECEPTACLES, DEVICES, ETC. AS NEEDED TO FACILITATE DEMOLITION. STORE DEVICES AND REINSTALL.
- REMOVE ALL ITEMS FROM WALLS WITHIN AREAS OF WORK AND PREPARE FOR NEW WORK.
- REMOVE EXISTING WALL BASE IN AREA OF WORK. WALL BASE VARIES PER LOCATION. CONTRACTOR TO FIELD VERIFY ALL CONDITIONS.
- COORDINATE EXISTING FIRE SPRINKLER DEMOLITION WITH NEW FIRE SPRINKLER DESIGN.

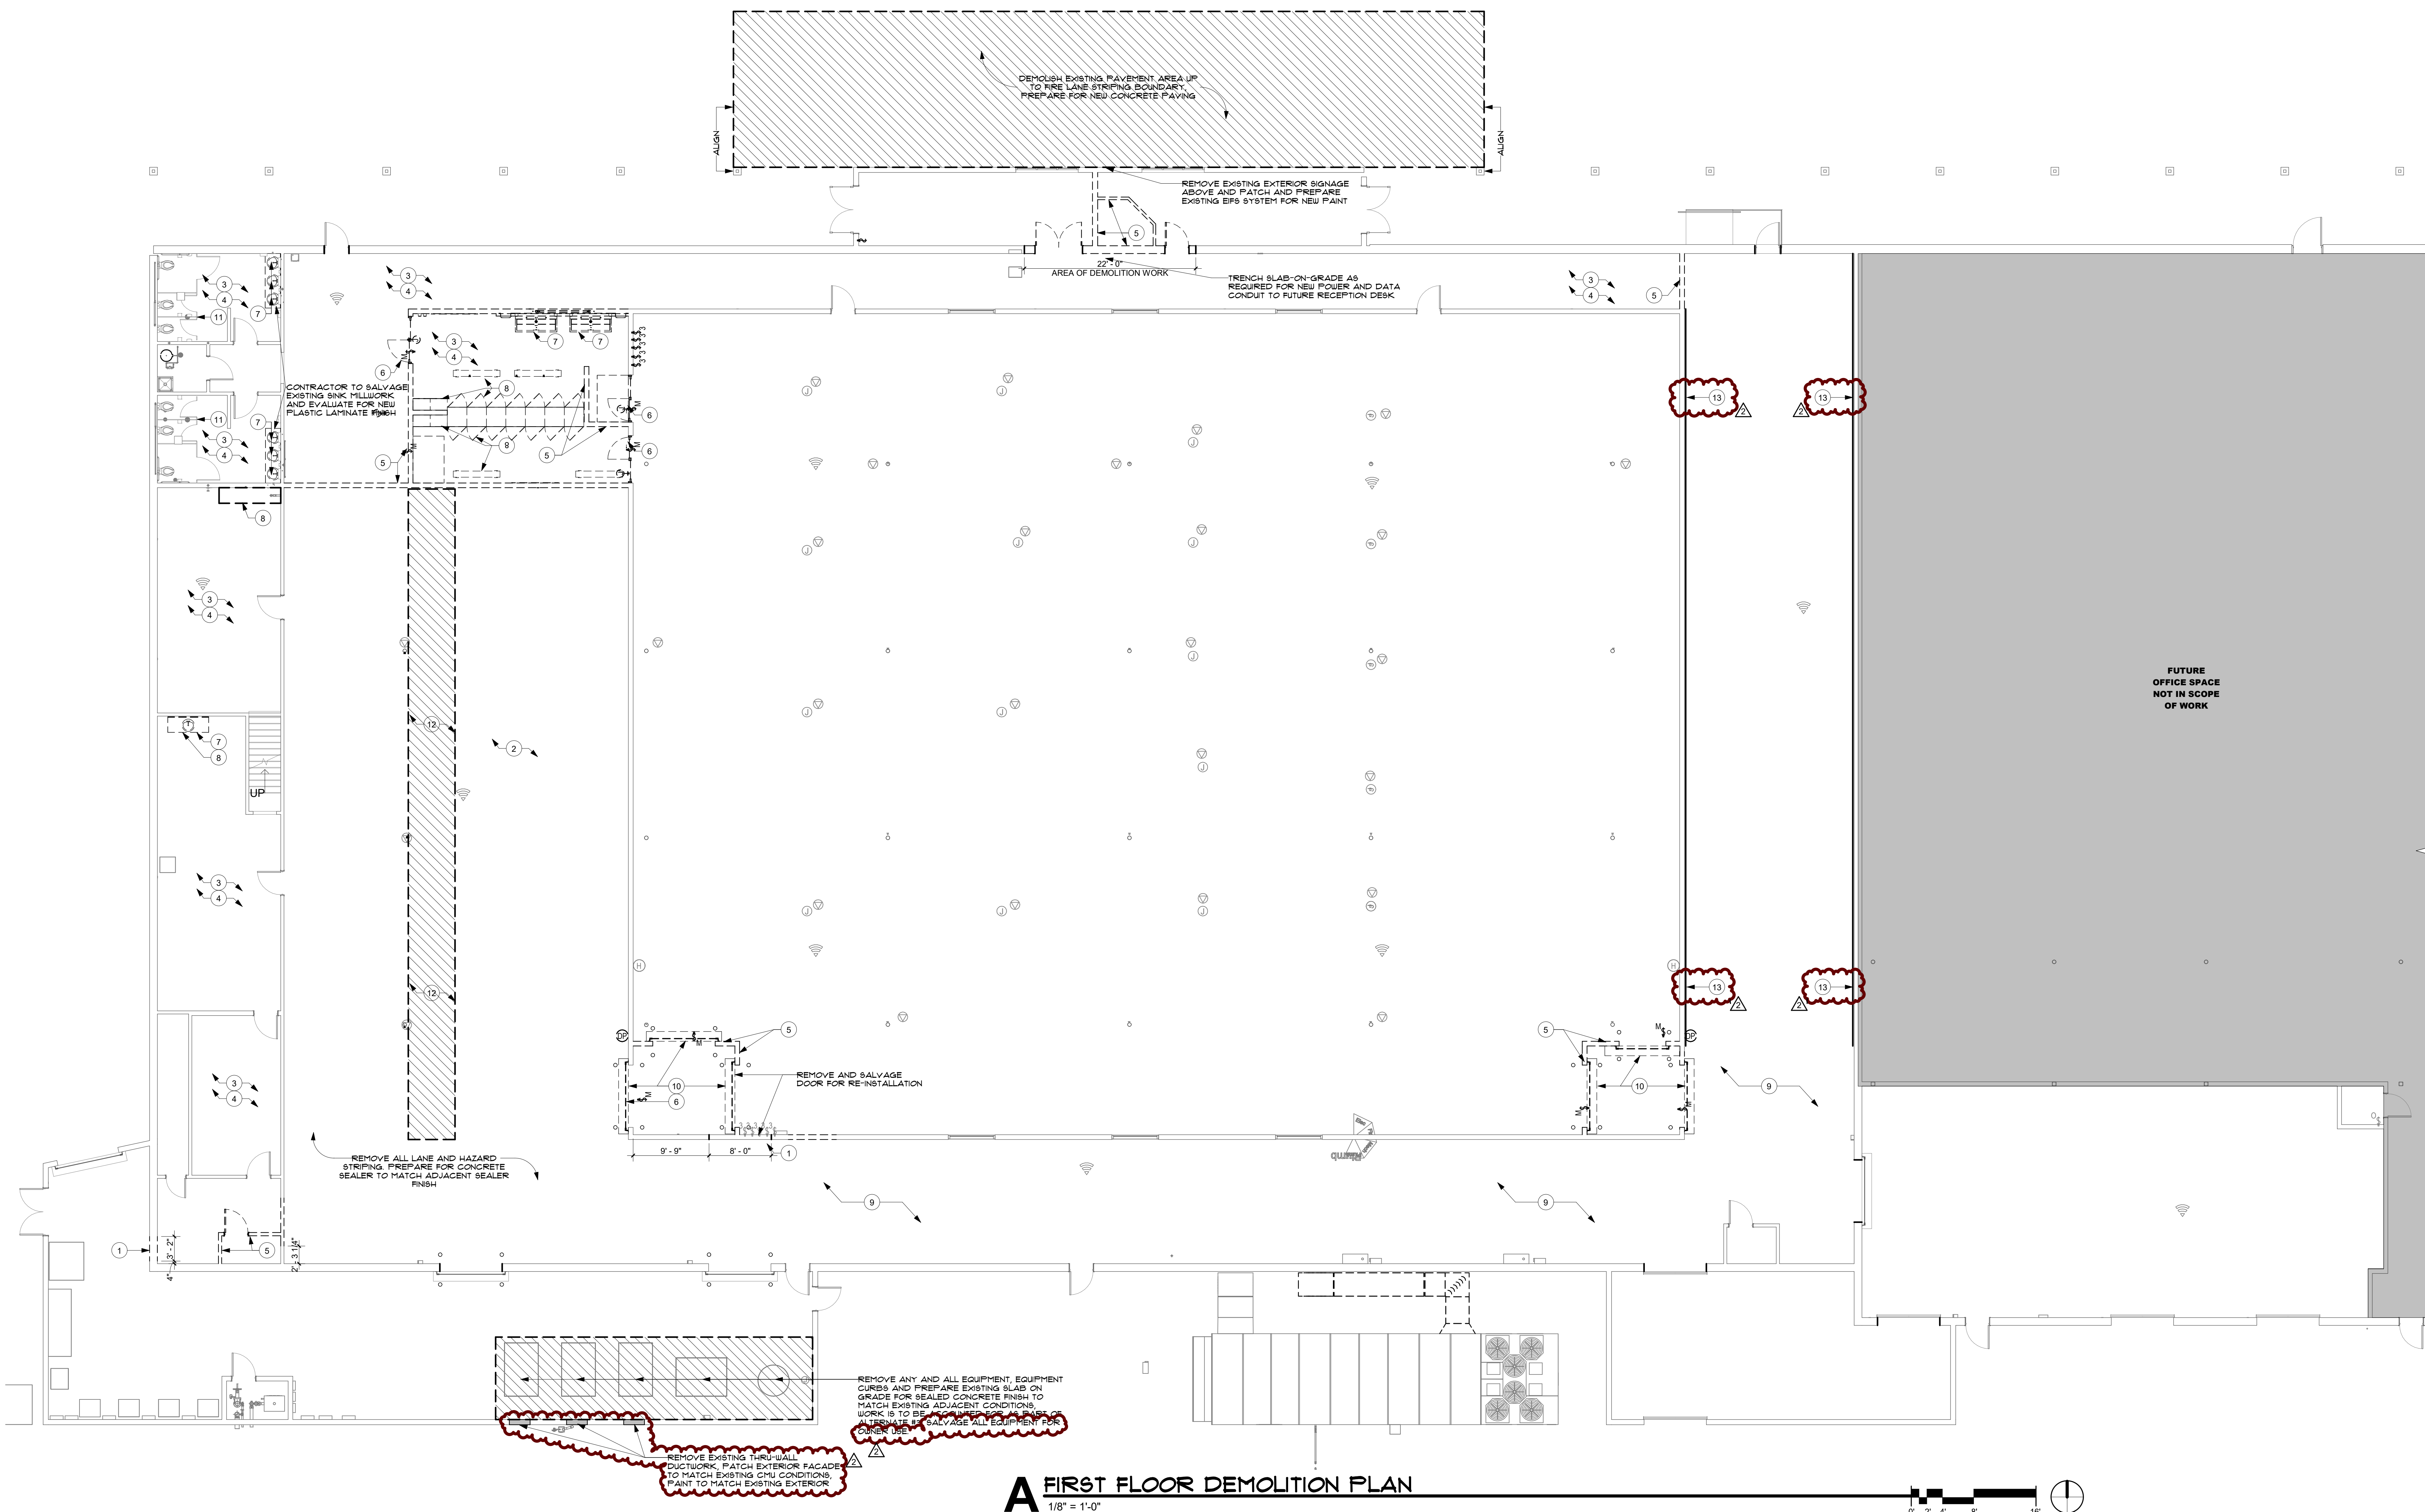

FIRST FLOOR DEMOLITION PLAN

1/8" = 1'-0"



- FLOOR PLAN GENERAL NOTES**
- ALL INTERIOR DIMENSIONS ARE TO THE FACE OF STUD, UNLESS NOTED OTHERWISE.
 - ALL EXTERIOR DIMENSIONS ARE FROM FACE OF EXTERIOR FINISH, UNLESS NOTED OTHERWISE.
 - UNLESS DIMENSIONED OTHERWISE, ALL DOOR FRAMES TO BE LOCATED 4" FROM ADJACENT PERPENDICULAR WALL.
 - EQUIPMENT IS SHOWN HERE FOR COORDINATION AND BACKING PURPOSES ONLY. MAKES AND MODELS SHALL BE CONFIRMED WITH OWNER. VERIFY EQUIPMENT. COORDINATE UTILITIES FOR EQUIPMENT WITH EQUIPMENT LIST AND DRAWINGS. IT IS THE RESPONSIBILITY OF THE CONTRACTOR TO VERIFY AND COORDINATE ALL EQUIPMENT, INCLUDING BUT NOT LIMITED TO WEIGHT, LOCATION, BACKING REQUIREMENTS POWER AND CLEARANCES.
 - PROVIDE CONTROL JOINTS PER MANUFACTURER'S SPECIFICATIONS.
 - CONTRACTOR TO INCLUDE AN ALLOWANCE OF \$2,000 FOR MINOR REPAIRS REQUIRED AT EXISTING TOILET PARTITIONS.
 - CONTRACTOR TO INCLUDE AN ALLOWANCE OF \$5,000 FOR MINOR REPAIRS REQUIRED AT EXISTING COVERED SIDEWALK AND AT EXISTING MASONRY BRICK COLUMNS.
 - CONTRACTOR TO INCLUDE AN ALLOWANCE OF \$10,000 FOR IMPROVEMENTS TO FACILITY SIGNAGE LOCATED ALONG WEST LOCUST STREET

- PARTITION TYPES GRAPHICS CONVENTION**
- TYPICAL PARTITION WITH NO SPECIAL MATERIALS OR RATINGS
- STANDARD PARTITION
- EXISTING PARTITION TO REMAIN. APPLY NEW FINISH.
- EXISTING PARTITION

EQUIPMENT LEGEND		PLAN DESIGNATOR: (XX)		
NO.	DESCRIPTION	C.F.C.I.	O.F.C.I.	MODEL NUMBER
01	KWIK-WALL 2000 SERIES OPERABLE WALL	○		KWIK WALL 2030
02	KOALA KARE BABY CHANGING STATION	○		KOALA KARE KB-300 SS
03	ALTERNATE #3 - OLYMPIC KILN	○		OLYMPIC KILNS FL20E




ABBREVIATIONS:
C.F.C.I. = CONTRACTOR FURNISHED, CONTRACTOR INSTALLED
O.F.C.I. = OWNER FURNISHED, CONTRACTOR INSTALLED
O.F.O.I. = OWNER FURNISHED, OWNER INSTALLED

PARTITION TYPES NAMING CONVENTION	
STRUCTURE	SUB-TYPE
A 7/8" HAT CHANNEL	a 6" ABOVE CEILING, BRACED HEAD (OR STR TO STRUCTURE ABOVE IF UNDER 24")
B 1/8" METAL STUD	b TO UNDERSIDE OF STRUCTURE ABOVE
C 2 1/2" METAL STUD	c STR TO UNDERSIDE OF STRUCTURE ABOVE, GYP TO 6" ABOVE CEILING
D 3/8" METAL STUD	d STR & GYP ONE SIDE TO STRUCTURE, GYP OTHER SIDE TO 6" ABOVE CEILING
E 6" CMU	e STR & GYP ONE SIDE TO STRUCTURE, GYP OTHER SIDE TO 6" ABOVE CEILING
FIRE RESISTANCE RATING	
0 NON-RATED	X SMOKE PARTITION, SMOKE BARRIER OR WALL RESISTING THE PASSAGE OF SMOKE
1 1 HOUR	
2 2 HOUR	
3 3 HOUR	
4 4 HOUR	
EXAMPLE	
D6	D = 3 3/8" METAL STUD
13E	E = SOUND PARTITION
	I = 1 HR FIRE RESISTANCE RATING (OPTIONAL)
	X = SMOKE RATED PARTITION
GENERAL NOTES	
1. ALL INTERIOR WALLS TO HAVE SOUND ATTENUATION	
2. WALLS AROUND MANUFACTURING TO HAVE DEFLECTION TRACK AT HEAD WITH MINIMUM 1 1/2" DEFLECTION. WALL TO BE SEALED TO ROOF DECK	

DOOR SCHEDULE




Mark	Width	Height	Door Finish	Door Material	Door Type	Glazing Type	Frame Finish	Frame Material	Frame Type	Comments
104	6'-0"	7'-0"	PT-2	HM	A2	GL-01	PT-2	HM	A	2
105	3'-0"	7'-0"	PT-2	HM	C1	GL-01	PT-2	HM	A	2
106	3'-0"	7'-0"	PT-2	HM	C1	GL-01	PT-2	HM	A	2
107	3'-0"	7'-0"	PT-2	HM	C1	GL-01	PT-2	HM	A	2
109	3'-0"	7'-0"	PT-2	HM	C5	GL-01	PT-2	HM	A	2
112A	6'-0"	7'-0"	PT-2	HM	A2		PT-2	HM	A	
112B	3'-0"	7'-0"	PT-2	HM	A1		PT-2	HM	A	
113	3'-0"	7'-0"	PT-2	HM	C1	GL-01	PT-2	HM	A	2
114A	6'-0"	7'-0"	PT-2	HM	A2		PT-2	HM	A	
114B	10'-0"	8'-0"	MANUF.	MANUF.			MANUF.	MANUF.	A	1
116A	6'-0"	7'-0"	PT-2	HM	A2		PT-2	HM	A	

NOTES:
1. BASIS OF DESIGN, OVERHEAD DOOR COMPANY, MODEL 610, POWER OPERATED
2. FULLY TEMPERED 1/4" GLAZING

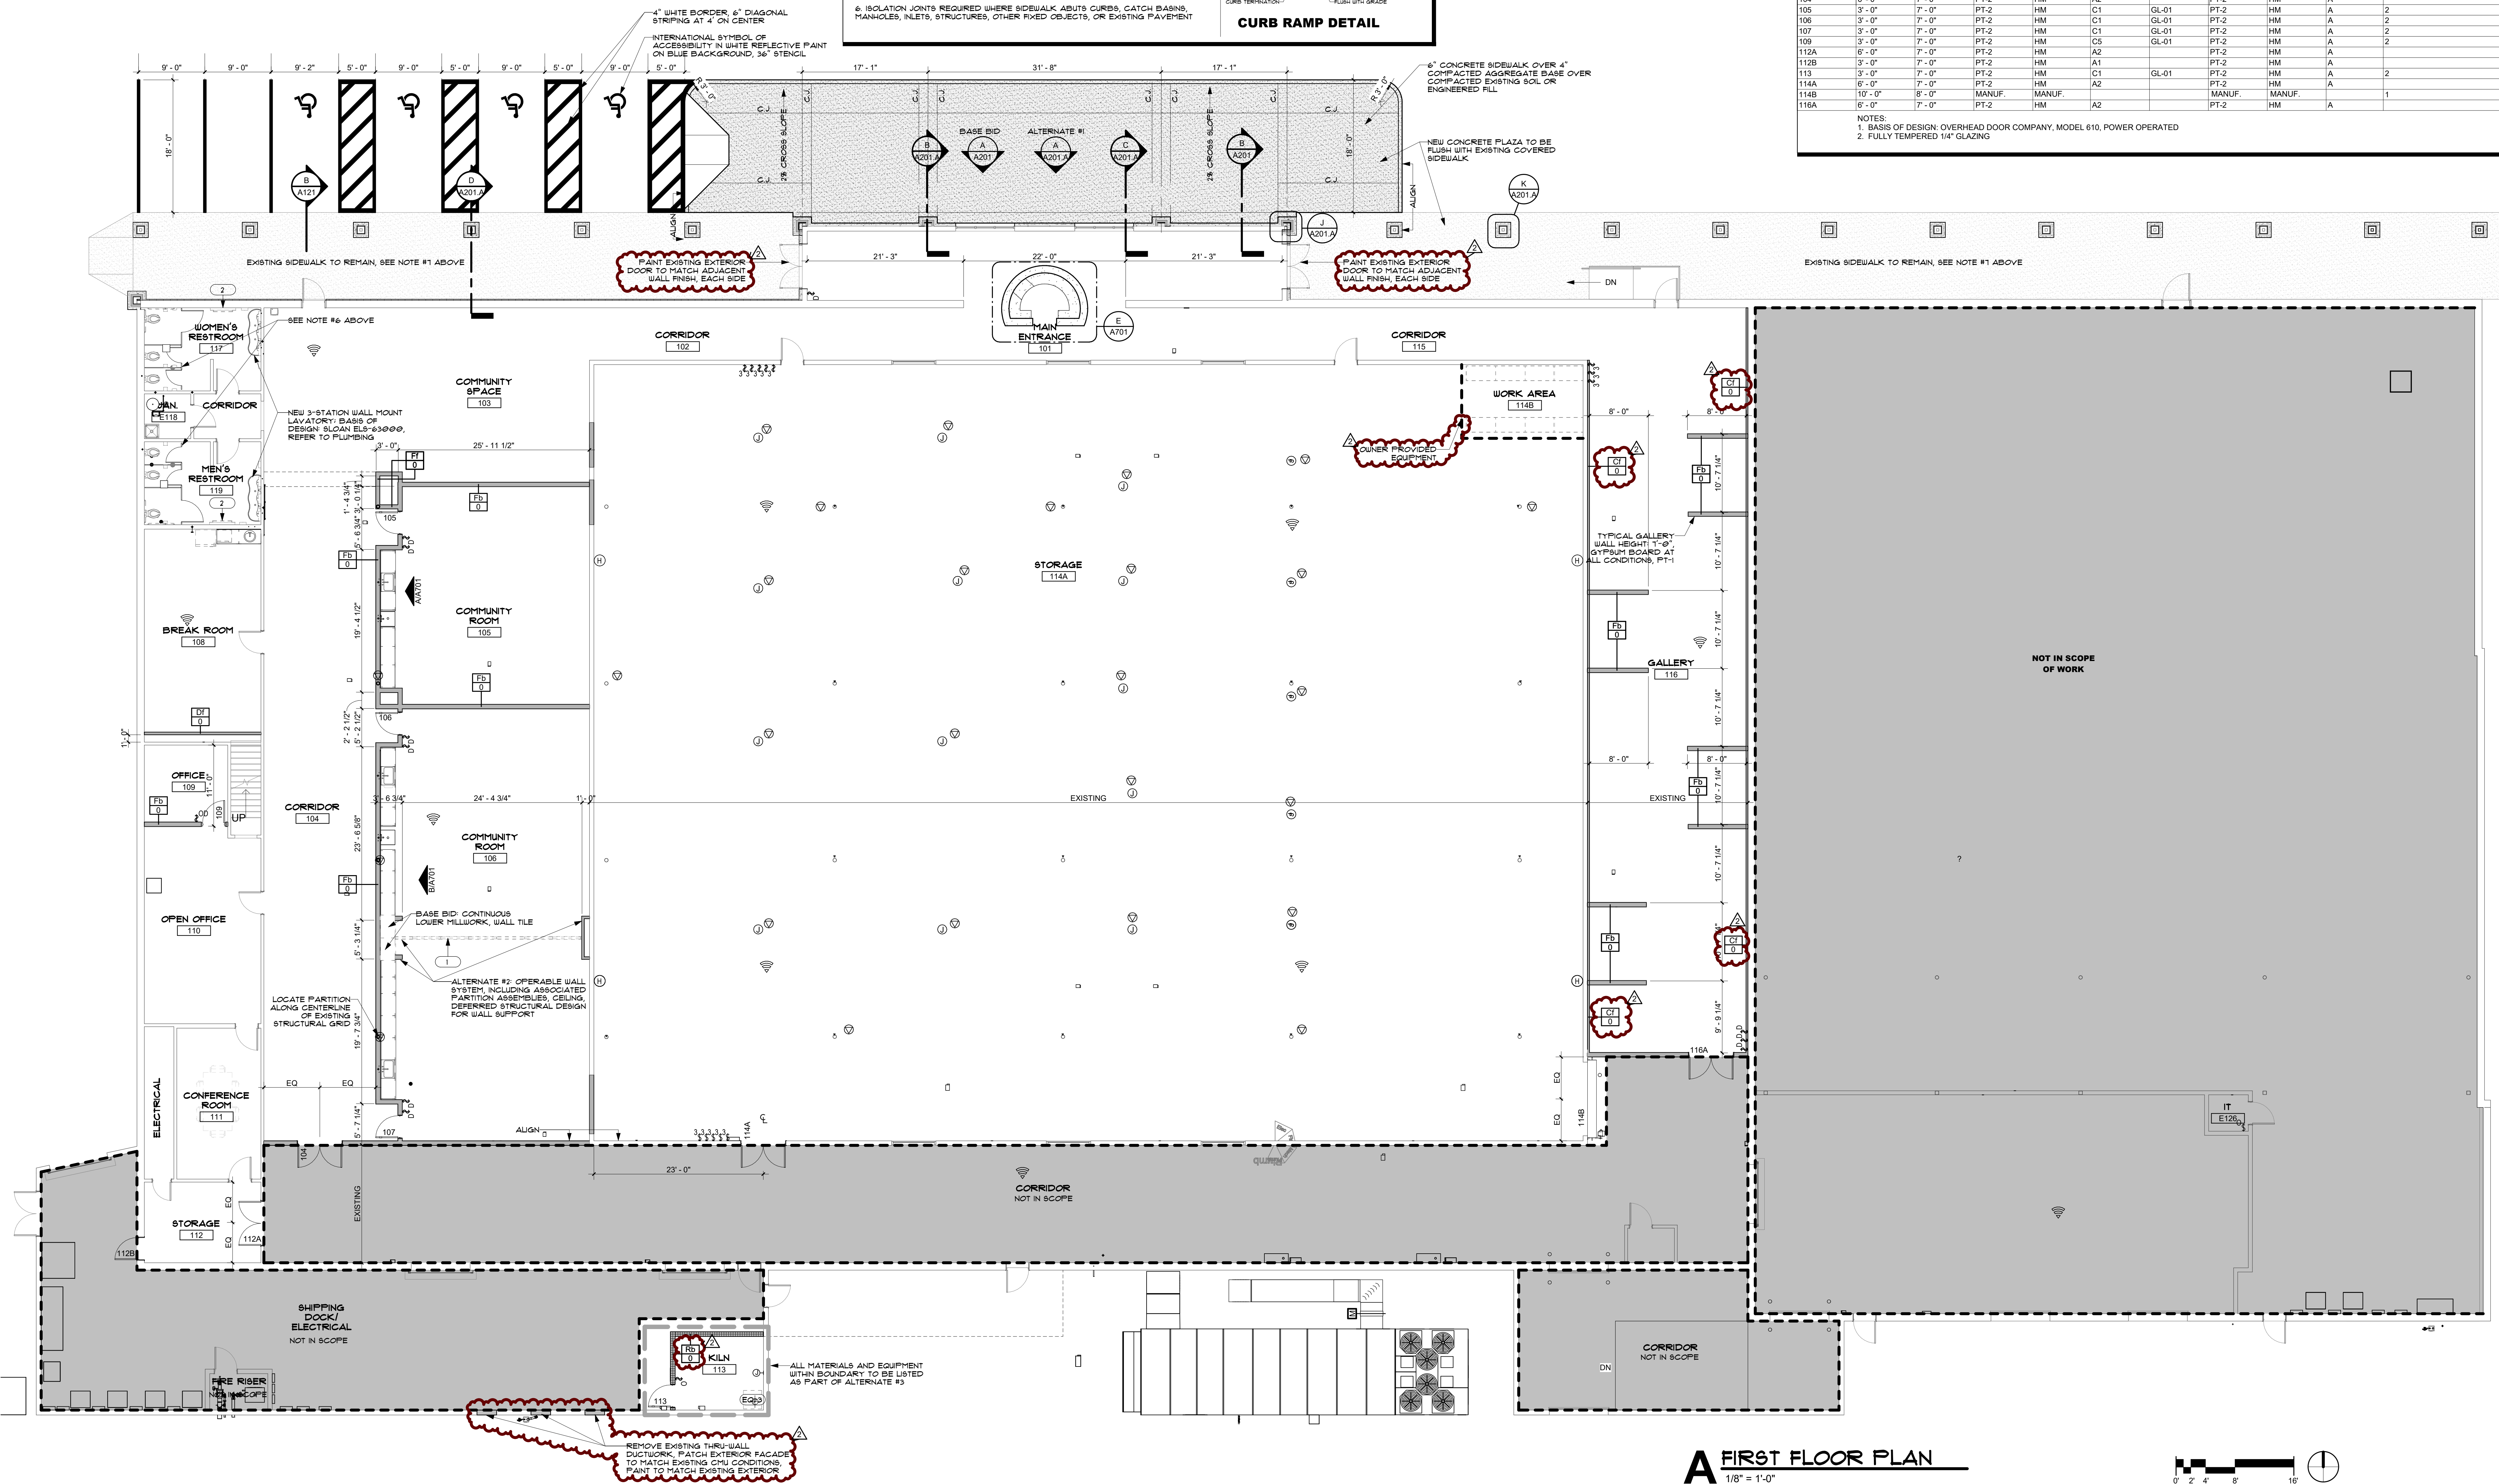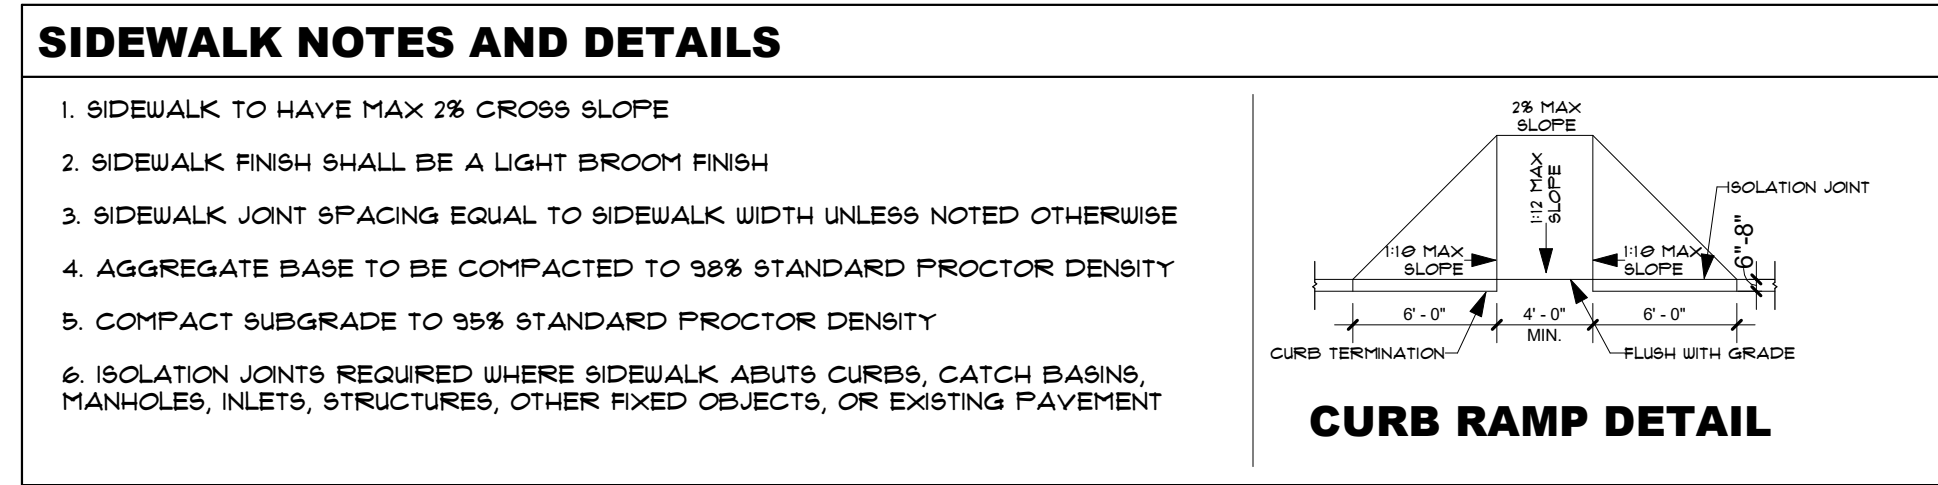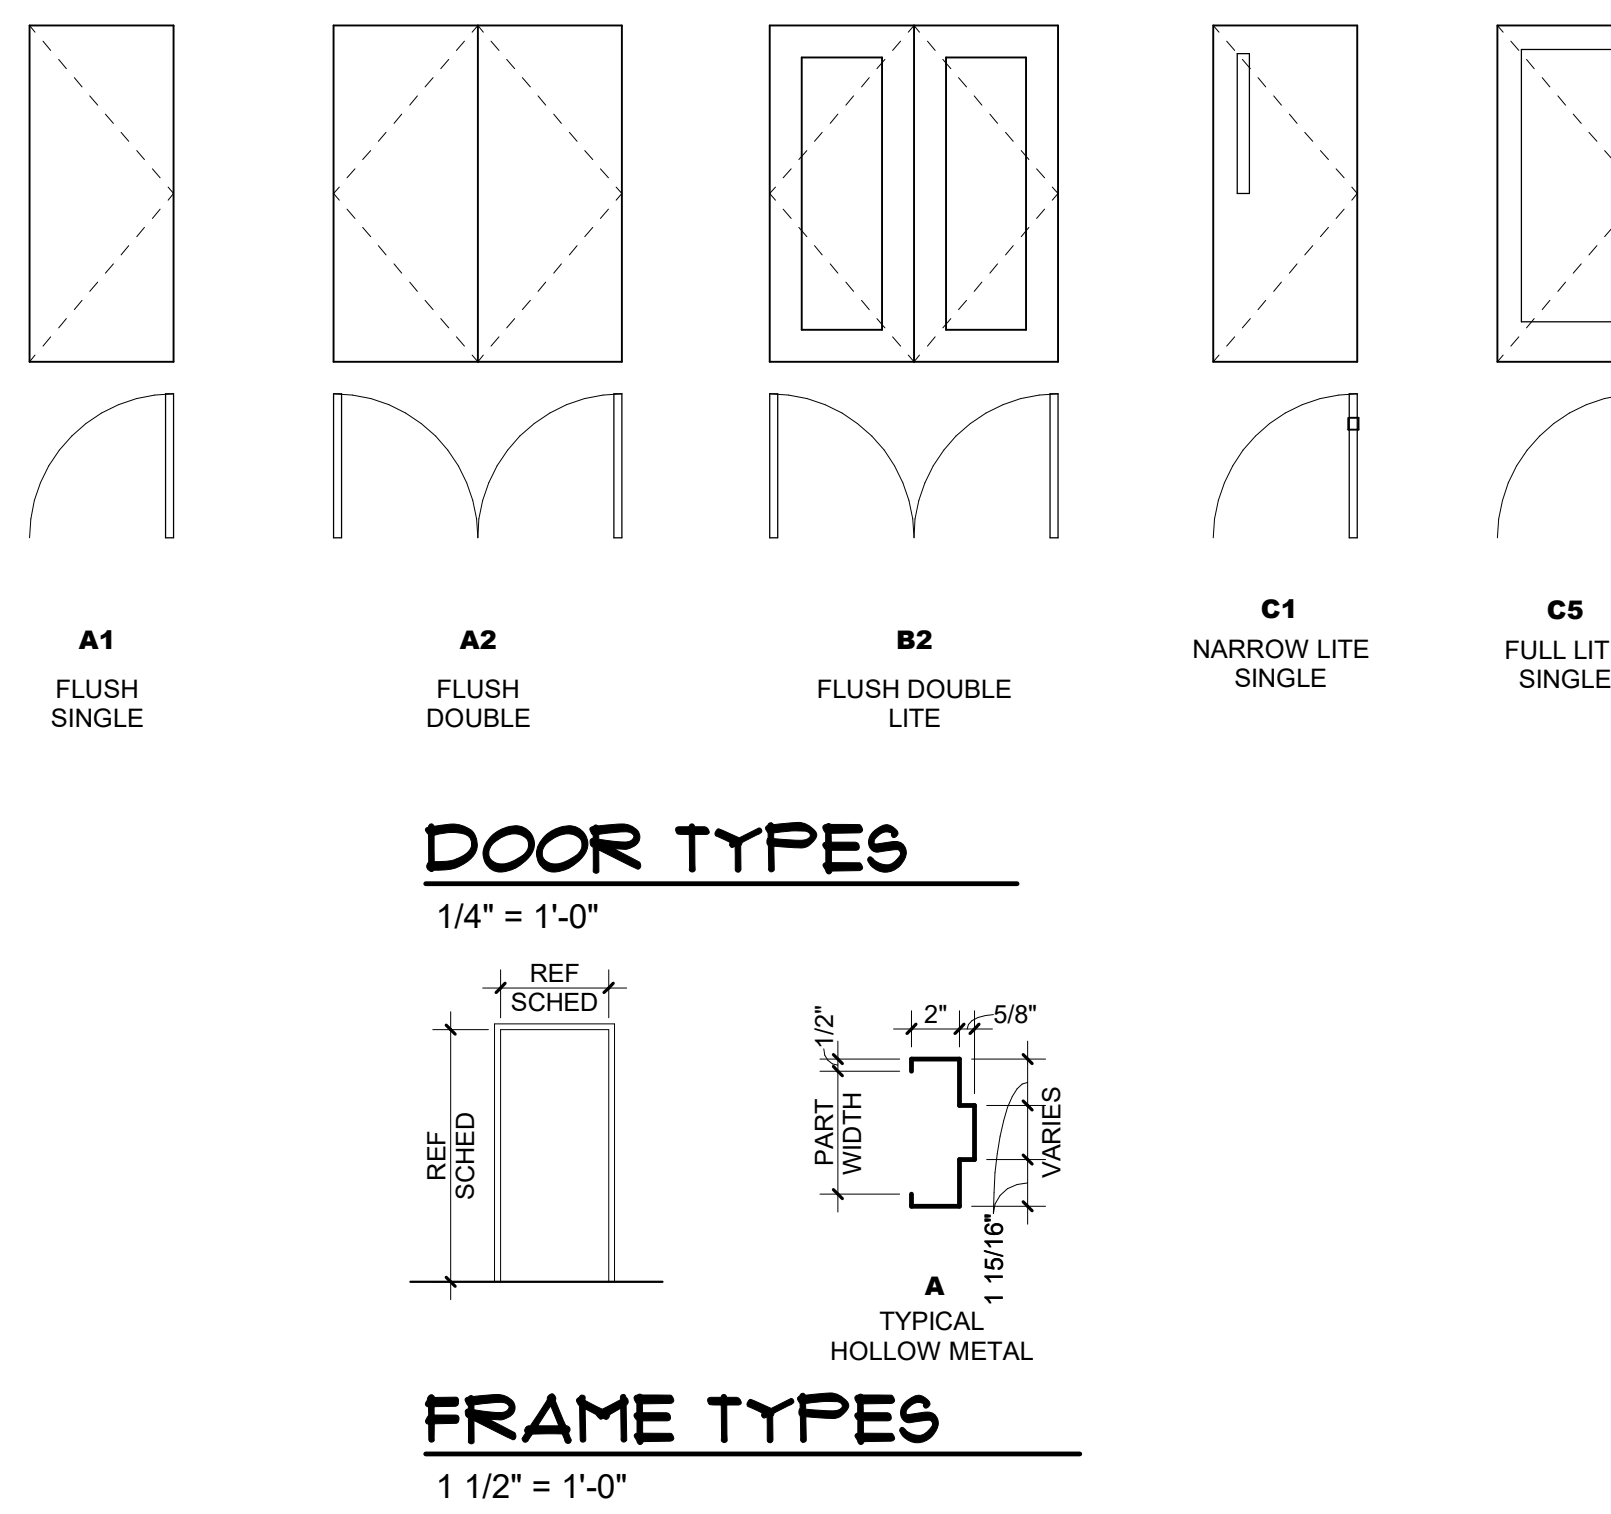

EQUIPMENT LEGEND		PLAN DESIGNATOR: (XX)		
NO.	DESCRIPTION	C.F.C.I.	O.F.C.I.	MANUFACTURER
01	KWIK-WALL 2000 SERIES OPERABLE WALL	○		KWIK WALL
02	KOALA KARE BABY CHANGING STATION	○		KOALA KARE
03	ALTERNATE #3 - OLYMPIC KILN	○		OLYMPIC KILNS
ABBREVIATIONS:				MODEL NUMBER
C.F.C.I. = CONTRACTOR FURNISHED, CONTRACTOR INSTALLED				2030
O.F.C.I. = OWNER FURNISHED, CONTRACTOR INSTALLED				KB-300 SS
O.F.C.I. = OWNER FURNISHED, OWNER INSTALLED				FL20E

REFLECTED CEILING PLAN LEGEND			
	2x2 LAY IN LENS		SUPPLY DIFFUSER
	2x4 LAY IN LENS		RETURN
	ACOUSTIC CEILING TILE - CLEANABLE (ACT)		EXHAUST FAN
	ACOUSTIC CEILING TILE (ACT)		SMOKE DETECTOR
	GYPSUM BOARD		CEILING HEIGHT
	SOFFIT PANEL BASIS OF DESIGN BERRIDGE VEE-PANEL, 24 GAUGE		EXIT SIGN
			RECESSED CAN LIGHT
			RECESSED MOUNTED LED LIGHT

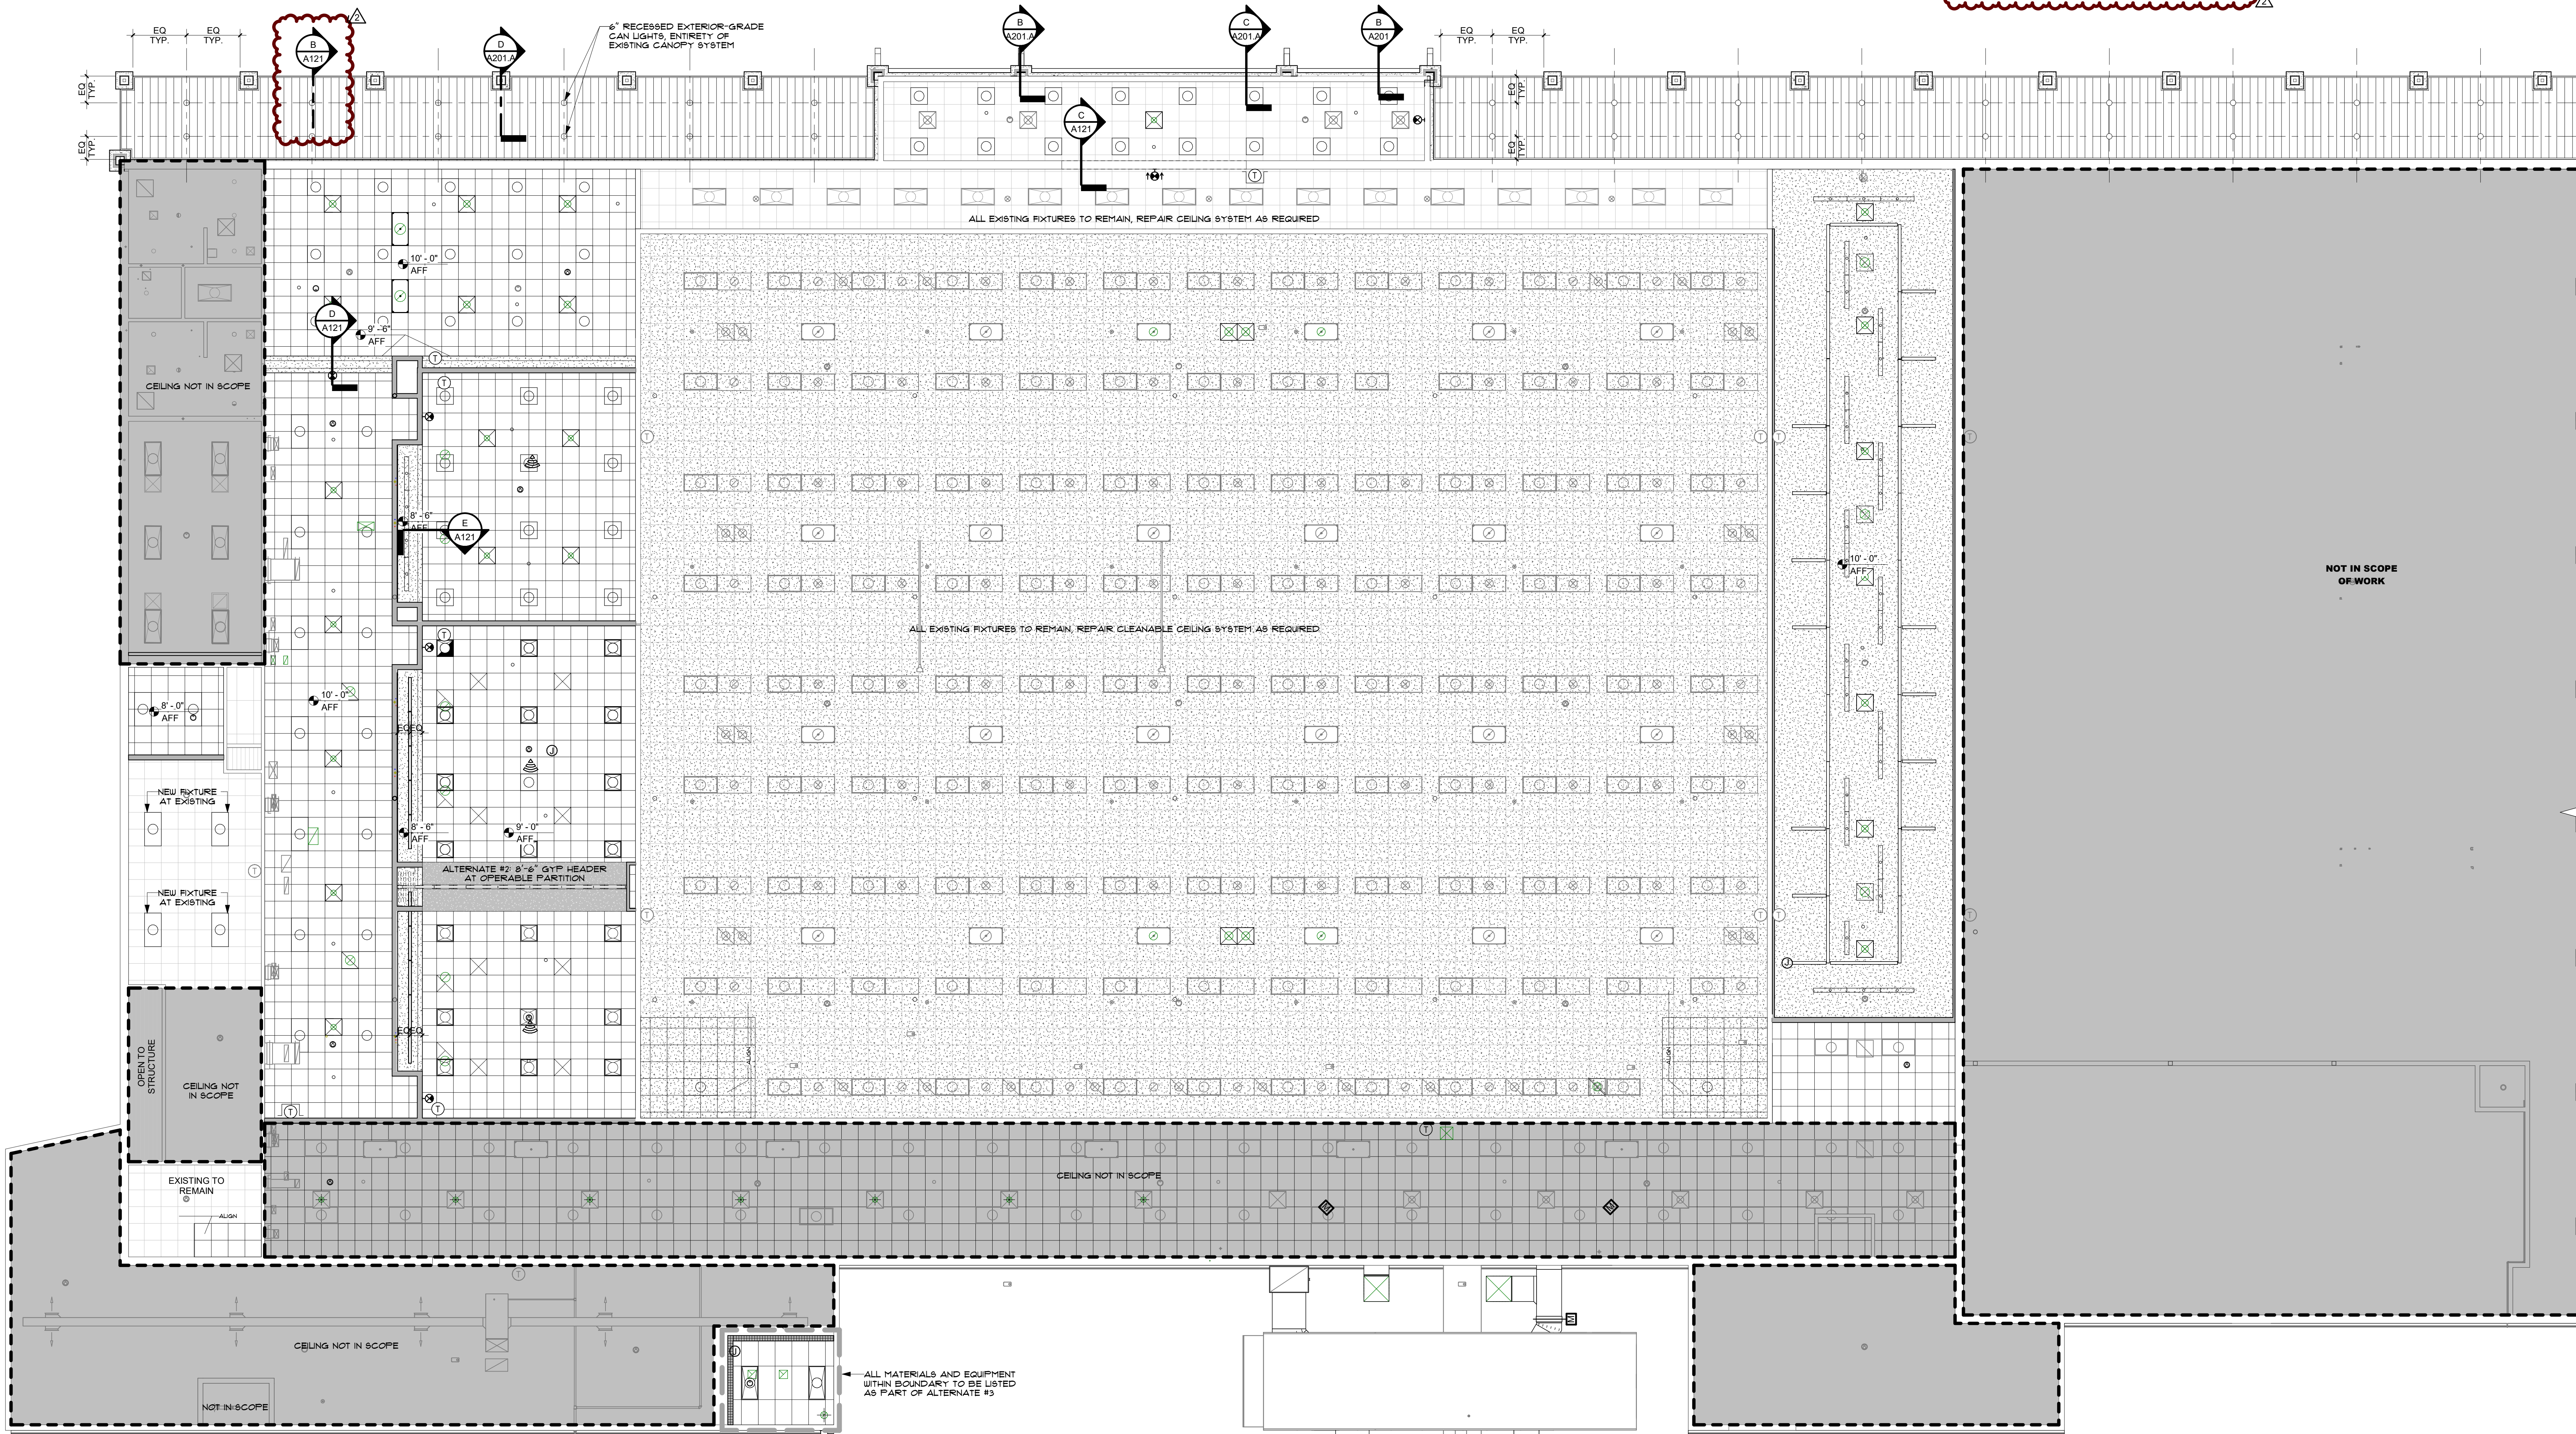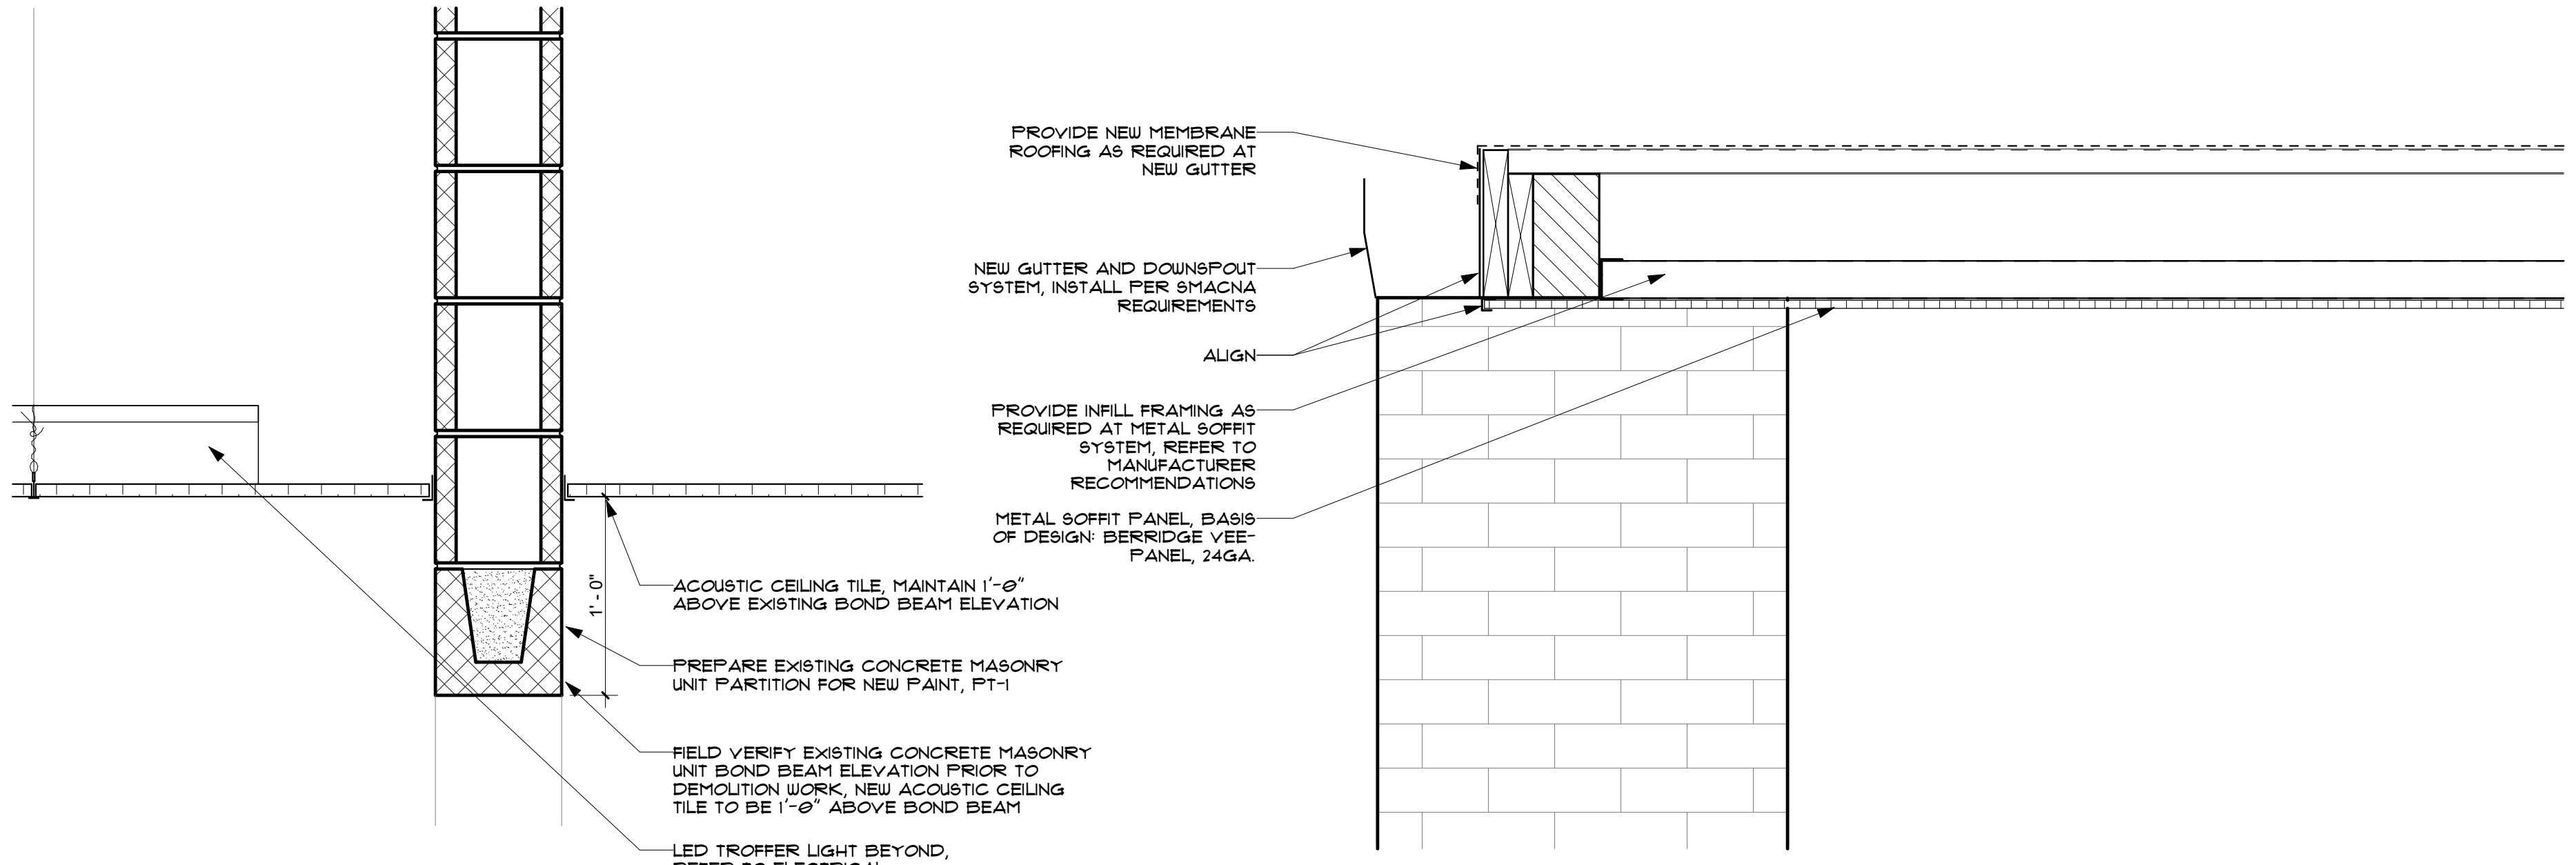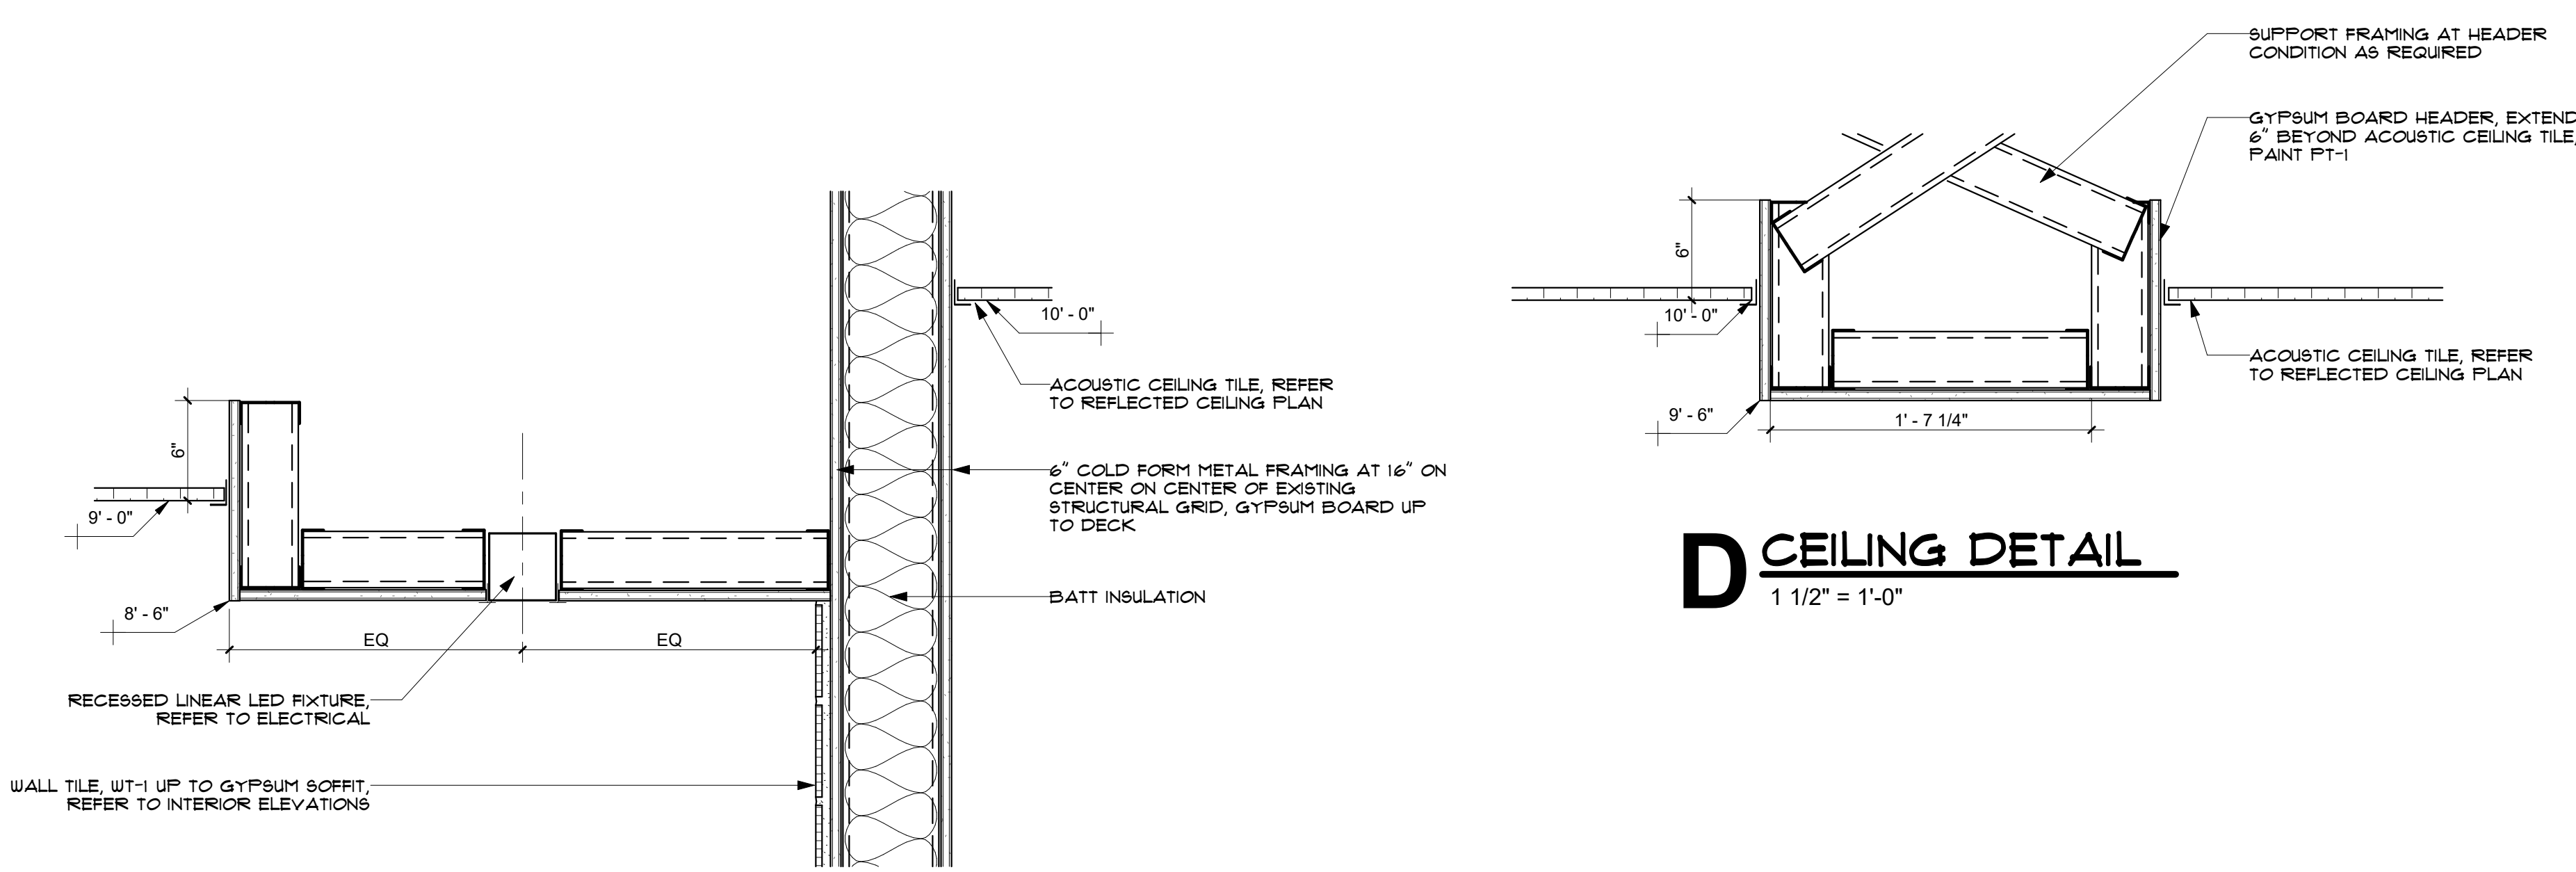

CHEROKEE NATION BUSINESSES - CULTURAL CENTER
314 W. LOCUST ST., STILLWELL, OK, 74960
CEILING PLANS AND DETAILS

blue river ARCHITECTS
A Native American Owned Firm
320 South Boston Avenue, Suite 103
Tulsa, Oklahoma 74103
918.408.6666
blueriverarchitects.com



ARCHITECT: Thomas Seat
LICENSE # 4183
PROJECT #: 20200132

ISSUE DATES:		
CONSTRUCTION DOCUMENTS		02/19/2025
No.	Description	Date
2	ADDENDUM #01	04/21/2025


SHEET NUMBER:

A121

© 2025 COPYRIGHT BLUE RIVER ARCHITECTS, LLC

EXTERIOR IMPROVEMENTS - ALTERNATE #1

PROJECT BASE BID IS TO INCLUDE ALL INFORMATION ON SHEET A201. REFER TO THIS SHEET FOR EXTERIOR IMPROVEMENTS ALTERNATE #1. CONTRACTOR TO PROVIDE LINE ITEM FOR ALTERNATE SCOPE OF WORK.

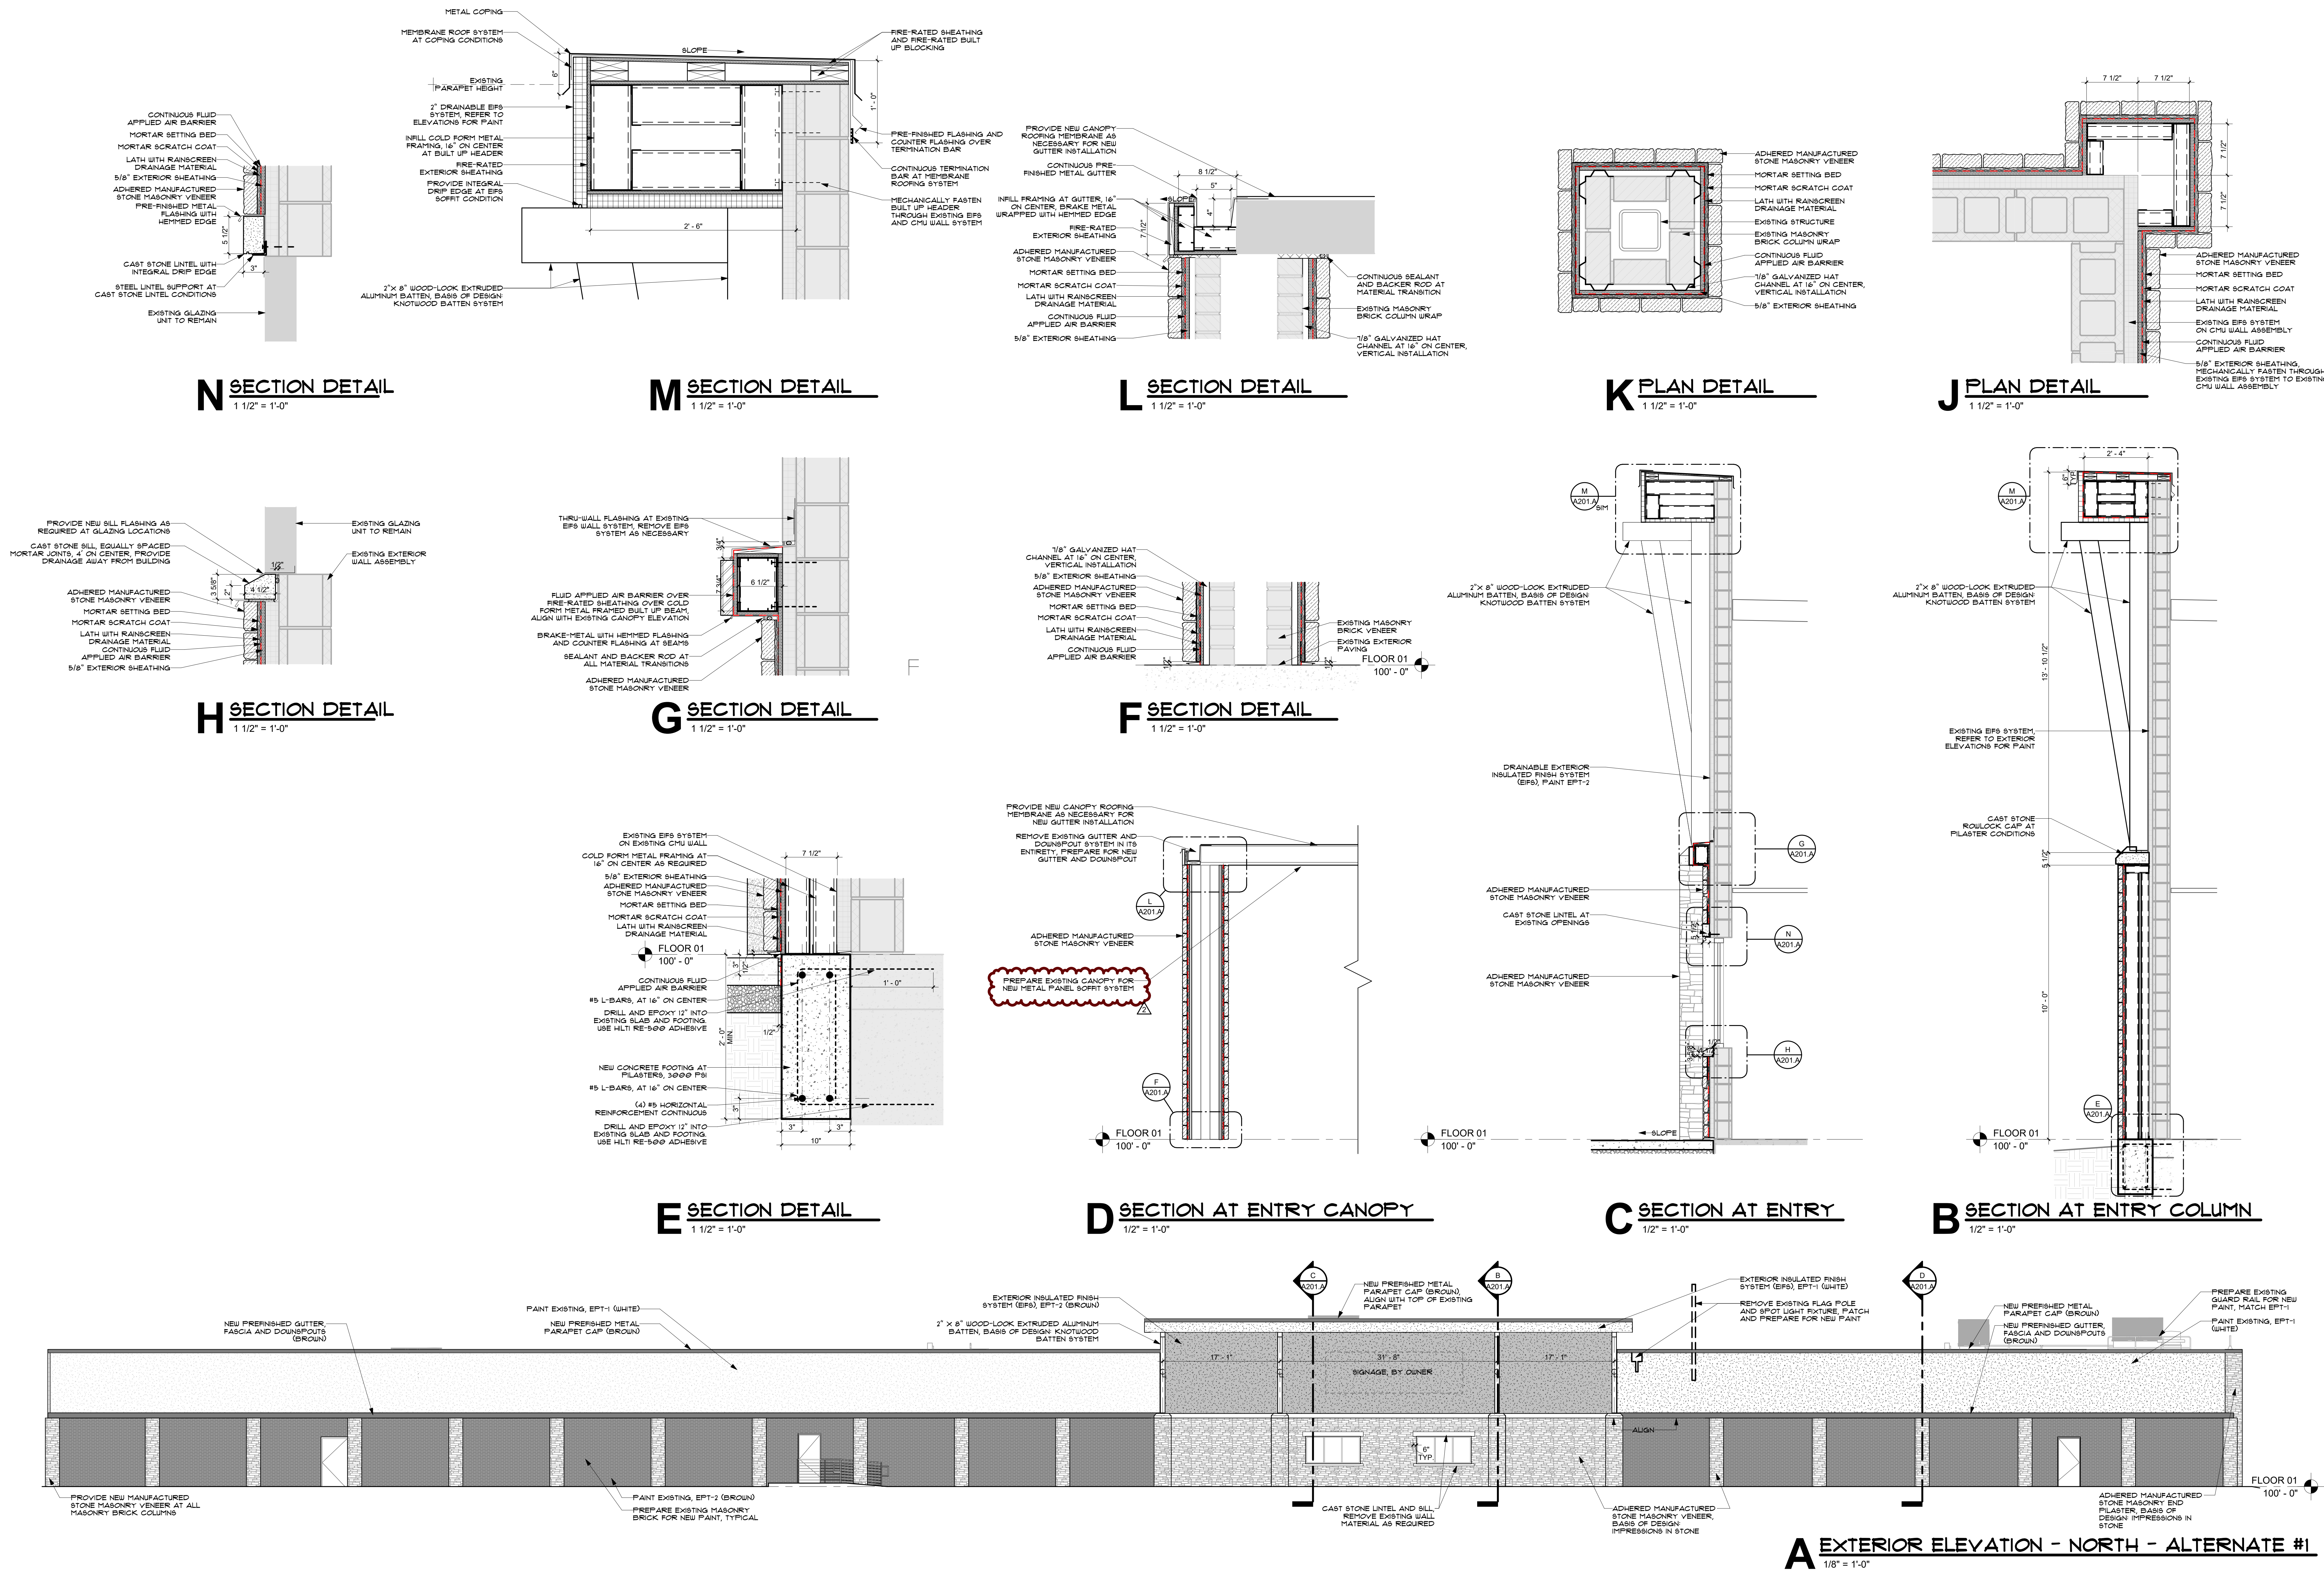

CHEROKEE NATION BUSINESSES - CULTURAL CENTER

314 W. LOCUST ST., STILLWELL, OK, 74960

EXTERIOR ELEVATIONS AND DETAILS - ALTERNATE #1

blue river ARCHITECTS
A Native American Owned Firm

320 South Boston Avenue, Suite 103
Tulsa, Oklahoma 74103
918.408.6666
blueriverarchitects.com

STATE OF OKLAHOMA
THOMAS C. SEAT
TULSA, OK
LICENSED ARCHITECT
4/21/2025
ARCHITECT: Thomas Seat
LICENSE # 4183

PROJECT #: 20200132

ISSUE DATES:
CONSTRUCTION DOCUMENTS 02/19/2025
No. Description Date
2 ADDENDUM #01 04/21/2025

SHEET NUMBER:

A201.A
© 2025 COPYRIGHT BLUE RIVER ARCHITECTS, LLC

1. ALL NEW BUILDING MATERIALS AND PRODUCTS SHALL NOT CONTAIN ASBESTOS
2. REFER TO ROOM FINISH SCHEDULE FOR ADDITIONAL INFORMATION AT BACK OF HOUSE AND NON-ELEVATED AREAS.
3. PROVIDE CORNER AND END WALL GUARDS AT OUTSIDE GYPSUM BOARD CORNERS.
4. WALL FINISHES TO HAVE MINIMUM CLASS "C" RATING FOR FLAME SPREAD AND SMOKE DEVELOPMENT.
5. FINISH MATERIALS AND PATTERNS ARE FOR GRAPHIC PURPOSES ONLY AND ARE NOT INTENDED TO SHOW EXACT PATTERN OR SIZES OF FINISHES.
6. PROVIDE 1/2" CEMENT BACKER BOARD AT ALL WALLS SHOWING TO RECEIVE TILE.
7. AT WALLS TO RECEIVE TILE: INSTALL TILE PATTERN CENTERED ON EACH MAIN WALL.
8. LEVEL LINE OF TILE INSTALLATION TO BE TAKEN AT THE TOP OF THE FIRST DOOR SLAB TO ALLOW TILE TO BE FLUSH WITH VARIATION IN FLOOR SLAB.
9. PROVIDE SEALANT AT ALL TILE INSIDE CORNERS AND AT DOOR FRAMES. COLOR TO MATCH ADJACENT GROUT COLOR.
10. USE SCHLUTER AQUACRYL TRANSITION STRIP AT ALL EXPOSED VERTICAL AND HORIZONTAL TILE TERMINATIONS AND ALL OUTSIDE CORNERS.

1. ALL GYPSUM BOARD WALLS TO BE PAINTED PT-1, UNLESS NOTED OTHERWISE.
2. DOOR FRAMES TO BE PT-2, UNLESS NOTED OTHERWISE.
3. ALL ELECTRICAL PANEL DOORS, AND WALL AND CEILING GRILLS ARE TO HAVE A FINISH TO MATCH ADJACENT SURFACE, UNLESS NOTED OTHERWISE.
4. SWITCH PLATES AND ELECTRICAL DEVICES ARE NOT TO BE PAINTED.

1. CHANGES IN FLOORING HEIGHTS UP TO 1/4" MAY BE VERTICAL AND WITHOUT REDUCING EDGE TREATMENT. CHANGES IN FLOORING HEIGHTS BETWEEN 1/4" AND 1/2" SHALL BE BEVELED WITH A SLOPE NO GREATER THAN 1:2. IF CHANGES IN FLOORING LEVEL ARE GREATER THAN 1/2", NOTIFY ARCHITECT FOR DETAILS TO PROVIDE ADA COMPLIANT RAMP.
2. FLOOR MATERIAL CHANGES TO OCCUR AT CENTER OF DOORS WHERE EXISTING.
3. PROVIDE STAINLESS STEEL SCHLUTER TRANSITION STRIP BETWEEN CHANGE IN FLOOR SURFACE, UNLESS NOTED OTHERWISE.
4. PROVIDE THRESHOLD AT TRANSITION FROM WET AREAS.
5. REMOVE ALL EXISTING TRAFFIC STRIPING AT AREAS TO REMAIN C-1. PROVIDE CONCRETE SEALER TO MATCH EXISTING.


1. CONTRACTOR TO FIELD MEASURE AND VERIFY ALL DIMENSIONS PRIOR TO FABRICATION AND INSTALLATION OF MILLWORK.
2. REFER TO FLOOR PLANS AND INTERIOR ELEVATIONS FOR EXACT LOCATIONS OF MILLWORK.
3. COUNTERTOPS AND BACKSPLASHES TO RECEIVE CLEAR SEALANT AT WALL WHERE REQUIRED.
4. ALL SOLID SURFACE COUNTERTOPS TO BE SS-1.
5. PROVIDE SIDE, TOP, AND BOTTOM FILLER PIECES AS REQUIRED TO COMPLETE THE CASEWORK AS INDICATED ON THE PLANS AND INTERIOR ELEVATIONS.
6. PROVIDE FINISHED END PANELS AT ALL EXPOSED CABINET ENDS, KNEE SPACES, AND BANQUETTE ENDS.

FLOOR FINISH	WALL FINISH - INTERIOR (CONTINUED)	CEILING FINISH (CONTINUED)
LVT-1 LUXURY VINYL TILE MANUF: SHAW CONTRACT STYLE: SOUNDSCAPE COLOR: FROM MANUF. FULL RANGE SIZE: 9' X 48" BRICK PATTERN	WFT-1 WALL TILE MANUF: DALTLE STYLE: COLOR WHEEL LINEAR COLOR: TO BE SELECTED BY OWNER SIZE: 12" X 12" STICKED HORIZONTAL	P-T4 GYPSUM CEILING PANEL MANUF: SHERWIN WILLIAMS STYLE: FLAT COLOR: SW7005 EXTRA WHITE
FT-1 FLOOR TILE MANUF: CROSSVILLE STYLE: "P" THRUOS COLOR: FROM MANUF. FULL RANGE SIZE: 12" X 12" SQUARES INCLUDE: 4" X 24" TRIM	WALL FINISH - EXTERIOR	MISCELLANEOUS
C-1 SEALED CONCRETE MANUF: H&C STYLE: HYDRO-OFFEND MATCH EXISTING CONDITIONS	EPT-2 GENERAL WALL PAINT MANUF: SHERWIN WILLIAMS STYLE: SEMI-GLOSS COLOR: FROM MANUF. FULL RANGE	PL-1 PLASTIC LAMINATE MANUF: WILSONART COLOR: 7960 STUDIO TEAK
WALL FINISH - INTERIOR	EPT-3 ACIDENT PAINT MANUF: SHERWIN WILLIAMS STYLE: EGGSHELL COLOR: FROM MANUF. FULL RANGE	SS-1 SOLID SURFACE COUNTERTOP, ALL COUNTERTOP LOCATIONS MANUF: CORIAN COLOR: ANTARCTICA EASED EDGES, TYPICAL
PT-1 GENERAL WALL PAINT MANUF: SHERWIN WILLIAMS STYLE: EGGSHELL COLOR: SW7005 EXTRA WHITE	CEILING FINISH	RB-1 RUBBER BASE MANUF: TARRETT STYLE: COVE COLOR: MOON ROCK WG CONFIRM EXISTING RUBBER BASE COLOR
PT-2 DOOR FRAME PAINT (INK ONLY) MANUF: ARMSTRONG CELINGS STYLE: SEMI-GLOSS COLOR: SW7668 MARCH WINDS	A-1 ACOUSTIC CEILING TILE MANUF: ARMSTRONG CELINGS STYLE: CALIA COLOR: WHITE SIZE: 24" X 48" GRID: SQUARE IAYN=1516"	
PT-3 ACCENT PAINT MANUF: SHERWIN WILLIAMS STYLE: EGGSHELL COLOR: TO MATCH CLARK-KINGSTON 3267 HIDDEN MAGIC REFER TO FINISH PLAN FOR LOCATIONS		

ROOM NUMBER	ROOM NAME	FLOOR FINISH	BASE FINISH	NORTH WALL	EAST WALL	SOUTH WALL	WEST WALL	CEILING FINISH	COMMENTS
101	MAIN ENTRANCE	LVT-1	RB-1	PT-1	PT-1	PT-3	PT-1	ACT-1	
102	CORRIDOR	LVT-1	RB-1	PT-1	PT-1	PT-3	PT-1	ACT-1	
103	COMMUNITY SPACE	LVT-1	RB-1	PT-1	PT-1	PT-3	PT-1	ACT-1	
104	CORRIDOR	LVT-1	RB-1	PT-1	PT-1	PT-1	PT-1	ACT-1	
105	COMMUNITY ROOM	C-1	RB-1	PT-1	PT-3	PT-1	PT-1 W/F1	ACT-1	
106	COMMUNITY ROOM	C-1	RB-1	PT-3	PT-1	PT-1	PT-1 W/F1	ACT-1	
108	BREAK ROOM	LVT-1	RB-1	PT-1	PT-1	PT-1	PT-1	ACT-1	
109	OFFICE	LVT-1	RB-1	PT-1	PT-1	PT-1	PT-1	ACT-1	
110	OFFICE	LVT-1	RB-1	PT-1	PT-1	PT-1	PT-1	ACT-1	
110	CONFERENCE ROOM	LVT-1	RB-1	EXISTING TO REMAIN	EXISTING TO REMAIN	EXISTING TO REMAIN	EXISTING TO REMAIN	EXISTING TO REMAIN	PATCH AND REPAIR WALLS AS REQUIRED AT RB-1
112	STORAGE	EXISTING TO REMAIN	RB-1	PT-1	EXISTING TO REMAIN	EXISTING TO REMAIN	PT-1	ACT-1	C-1 ONLY AT AREAS OF DEMOLITION
115	KITCHEN	GT	RB-1	EXISTING TO REMAIN	EXISTING TO REMAIN	EXISTING TO REMAIN	EXISTING TO REMAIN	EXISTING TO REMAIN	C-1 FINISH OVER EXISTING CONDITIONS HAVE BEEN REMOVED
114	STORAGE	EXISTING TO REMAIN	RB-1	EXISTING TO REMAIN	EXISTING TO REMAIN	EXISTING TO REMAIN	EXISTING TO REMAIN	EXISTING TO REMAIN	
114B	WORK AREA	EXISTING TO REMAIN	RB-1	EXISTING TO REMAIN	EXISTING TO REMAIN	EXISTING TO REMAIN	EXISTING TO REMAIN	EXISTING TO REMAIN	
115	CORRIDOR	LVT-1	RB-1	PT-1	PT-1	PT-3	PT-1	ACT-1	
116	GALLERY	LVT-1	RB-1	PT-1	PT-1	PT-1	PT-1	GYP, PT-1	
117	WOMEN'S RESTROOM	LVT-1	RB-1	PT-1	PT-1	PT-1	PT-1	PT-1	
119	MEN'S RESTROOM	LVT-1	RB-1	PT-1	PT-1	PT-1	PT-1	PT-1	



314 W. LOCUST ST., STILWELL, OK, 74960
INTERIOR FINISH PLAN

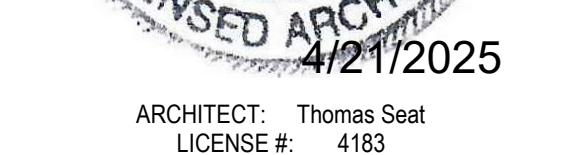

PROJECT #: 20200132

ISSUE DATES:		
CONSTRUCTION DOCUMENTS		02/19/2025
No.	Description	Date
2	ADDENDUM #01	04/21/2025

SHEET NUMBER:
ID101